

CODED

MISSISSIPPI
BOARD OF WATER COMMISSIONERS
416 North State Street
Jackson, Mississippi 39201

WATER WELL DRILLERS LOG

Pontotoc Co.
L 33
3-20-70

3-20 1970 Clark Bros. Pontotoc
date well completed firm name county well located

LANDOWNER:
Midway Baptist Church
Pontotoc Route
(mailing address)

description of formations encountered	from	to
gray dirt	0	12
gravel	12	24
Rock & Sand	24	34
Blue mud	34	164
Rock & Sand	164	200

WELL LOCATION:
sec. 9 T 11 N R 3 E
8 miles S. of Pontotoc
(distance) (direction) (nearest town)

WELL PURPOSE: Home
(home, irrigation, municipal, industrial)

WELL COMPLETION DATA:

(1) diameter (inches) 4"

(2) total depth (feet) 200'

(3) static water level (feet) 40' below top of ground.

(4) casing Metal, 65' (material) (depth)
4" (size) if telescope see back.

(5) screen None (length) (depth to top)

(6) pump 1 jet 7 (HP) (yield gpm)
Electric (type power)

(7) electric log no (yes or no)
(organization running log)

(8) how well bottom plugged no

CODED


APR 20 1970

DRILLERS REMARKS:

MISS. BD. OF
WATER COMMISSIONERS

If well telescopes please sketch and show depths.

GROUND LEVEL

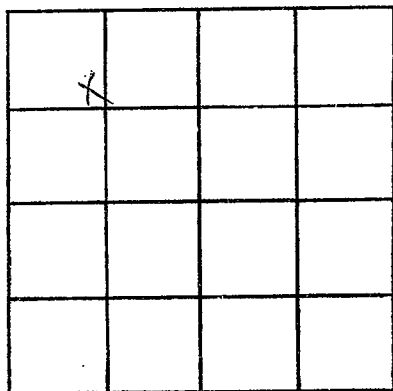

SECTION _____

Please indicate well location X.

ADDITIONAL INFORMATION

If more than one screen, show locations of each on sketch.