

Pontotoc
 L 34
 6-2-70

MISSISSIPPI
 BOARD OF WATER COMMISSIONERS
 416 North State Street
 Jackson, Mississippi 39201

CODED

WATER WELL DRILLERS LOG

6-2-70 19 Leeper Drilling Co. Pontotoc
 date well completed firm name county well located

LANDOWNER:
Kenneth Mills
Rt 5 Pontotoc
 (mailing address)

WELL LOCATION:
 sec. 23 T 11 R 3
10 miles SE of Pontotoc
 (distance) (direction) (nearest town)

WELL PURPOSE: home
 (home, irrigation, municipal, industrial)

- WELL COMPLETION DATA:
- (1) diameter (inches) 4
 - (2) total depth (feet) 950
 - (3) static water level (feet) 180 below above top of ground.
 - (4) casing Steel, 265'
 (material) (depth)
4 if telescope see back.
 (size)
 - (5) screen none
 (length) (depth to top)
 (size) (material)
 - (6) pump 1 9
 (HP) (yield gpm)
Elect
 (type power)
 - (7) electric log no
 (yes or no)
 (organization running log)
 - (8) how well bottom plugged open

description of formations encountered	from	to
Red clay & sand	0	40
Rock & Blue clay	40	90
Rock & Red sand	90	110
Blue clay	110	230
Blue clay	230	360
Blue clay & Chalk	360	800
Sand	800	950

CODED


JUN 20 1970

MISS. BD. OF
 WATER COMM.

DRILLERS REMARKS:

If well telescopes please sketch and show depths.

GROUND LEVEL

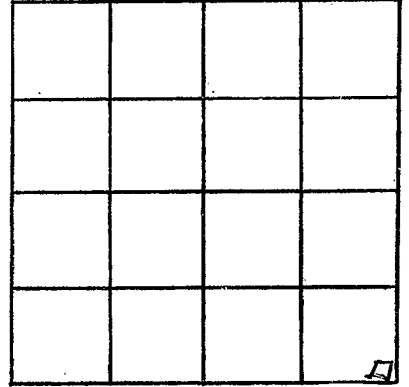

SECTION 23

Please indicate well location X.

ADDITIONAL INFORMATION

If more than one screen, show locations of each on sketch.