

PONTOTOC
 L37
 9-17-70

MISSISSIPPI
 BOARD OF WATER COMMISSIONERS
 416 North State Street
 Jackson, Mississippi 39201

CODED

WATER WELL DRILLERS LOG

Sept-17 1970 Clark Bros. Pontotoc
 date well completed firm name county well located

LANDOWNER:
 C. L. Mcmillian
 RT 4 - Pontotoc
 (mailing address)

description of formations encountered	from	to
Gravel	0	20
Rock & Sand	20	50
Blue mud	50	120
Rock & Sand	120	200

WELL LOCATION:
 sec. 20 T 11 N R 3 (E)
 9 miles S of Pontotoc
 (distance) (direction) (nearest town)

WELL PURPOSE: home
 (home, irrigation, municipal, industrial)

WELL COMPLETION DATA:

(1) diameter (inches) 4"

(2) total depth (feet) 200'

(3) static water level (feet) 50' below above top of ground.

(4) casing metal 63'
 (material) (depth)
4"
 (size) if telescope see back.

(5) screen none
 (length) (depth to top)
 (size) (material)

(6) pump 3 1/2 HP 5'
 (HP) (yield gpm)
Electric
 (type power)

(7) electric log no
 (yes or no)
 (organization running log) no

CODED

OCT 28 1970


(8) how well bottom plugged

MISS. BD. OF
 WATER COMM.

DRILLERS REMARKS:

If well telescopes please sketch and show depths.

GROUND LEVEL

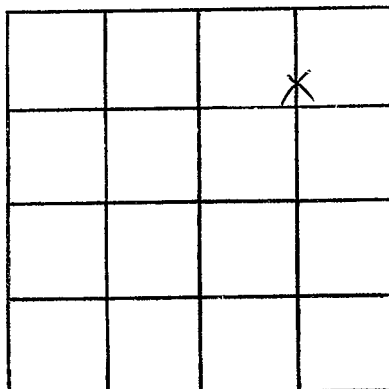

SECTION _____

Please indicate well location X.

ADDITIONAL INFORMATION

If more than one screen, show locations of each on sketch.