

PONTOTOC

L38

10-30-70

MISSISSIPPI
 BOARD OF WATER COMMISSIONERS
 416 North State Street
 Jackson, Mississippi 39201

CODED

WATER WELL DRILLERS LOG

10-30-1970
date well completed

Leepel Drilling Co. Pontotoc
firm name county well located

LANDOWNER:

Bob Berry

Rt 3 - Pontotoc
(mailing address)

description of formations encountered

from

to

Red clay & Red Sand
 Red Sand & Rock
 Blue Clay & Rock
 Limer Rock
 Sand

0 40
 40 55
 55 140
 140 180
 180 220

WELL LOCATION:

sec 27 T 11 N R 3 E
 S
 9 miles SW of Pontotoc
 (distance) (direction) (nearest town)

WELL PURPOSE: Home
 (home, irrigation, municipal, industrial)

WELL COMPLETION DATA:

- (1) diameter (inches) 4
- (2) total depth (feet) 220
- (3) static water level (feet) 80 below
top of ground.
- (4) casing Steel, 84
(material) (depth)
4 if telescope see back.
(size)
- (5) screen 0
(length) (depth to top)
(size) (material)
- (6) pump 3/4 6
(HP) (yield gpm)
E leaf
(type power)
- (7) electric log no
(yes or no)
(organization running log)
- (8) how well bottom plugged open

CODED


NOV 30 1970

MISS. BD. OF
WATER COMMISSIONERS

DRILLERS REMARKS:

If well telescopes please sketch and show depths.

GROUND LEVEL

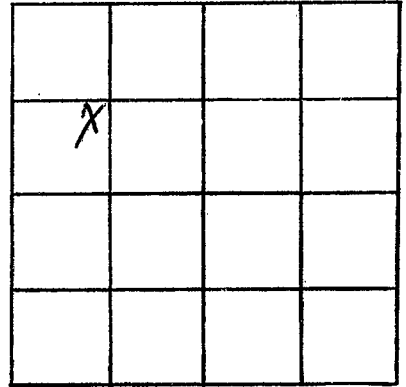

SECTION _____

Please indicate well location X.

ADDITIONAL INFORMATION

If more than one screen, show locations of each on sketch.