

PONTOTOC

L39

11-9-70

MISSISSIPPI BOARD OF WATER COMMISSIONERS  
416 North State Street  
Jackson, Mississippi 39201

**CODED**

WATER WELL DRILLERS LOG

11-9-1970  
date well completed

Leper Drilling Co.  
firm name

Pontotoc  
county well located

LANDOWNER:

Athene Berry  
Rt 3 - Pontotoc  
(mailing address)

description of formations encountered

from to

Red Clay & Sand	0	25
Sand & Rock	25	65
Blue Clay & Rock	65	140
Lime Rock	140	170
Sand	170	220

WELL LOCATION:

sec. 14 T 11 S R 3 E  
8 miles SW of Pontotoc  
(distance) (direction) (nearest town)

WELL PURPOSE: Home  
(home, irrigation, municipal, industrial)

WELL COMPLETION DATA:

- (1) diameter (inches) 4
- (2) total depth (feet) 220
- (3) static water level (feet) 100 below above top of ground.
- (4) casing steel, 84, (material) (depth)  
4 (size) If telescope see back.
- (5) screen 0 (length) (depth to top)  
(size) (material)
- (6) pump 3/4 6 (HP) (yield gpm)  
Electric (type power)
- (7) electric log no (yes or no)

**CODED**

NOV 30 1970

(organization running log)


(8) how well bottom plugged open

MISS. BD. OF WATER COMMISSIONERS

DRILLERS REMARKS:

If well telescopes please sketch and show depths.

GROUND LEVEL

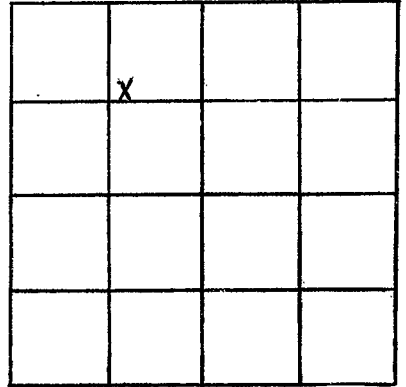

SECTION 14

Please indicate well location X.

ADDITIONAL INFORMATION

If more than one screen, show locations of each on sketch.