

RL 41
2-8-64

WATER WELL DRILLERS LOG

3
CODED

Date: 2-8, 1964, Driller: CFCARLISLE County: UNION
(Name)

(1) Owner of Land: TL MORPNIIS
(Name)
ALGOMA MISS RI
(Address)

(2) Location: 1/4, 1/4, Sec. 7 T11 R3,
5 miles S, of ALGOMA
(distance) (direction) (Nearest Town)

(3) Topography: X
(Hilly) (Flat) (Level)

(4) Purpose of Well: DOMESTIC
(Domestic Irrigation
Municipal, Industrial, Other)

Description & Color of Materials Sand, Clay, Red Clay, Shell, etc.	Thick- ness Feet	Depth Feet
GUMBO	30	
ROCK	40	70
BLUE DIRT	42	112
ROCK & SAND	37	149
W SAND	21	170

Information upon completion of well:

(1) Diameter 4 inches.

(2) Total Depth 170 feet.

(3) Water Level 30 feet below top of ground.

(4) Cased to 84, Size

(5) Screen: Size, Length


(6) Were any formations sealed against pollution?
yes, no.

CODED

If YES depth of formation

Why

Drillers Remarks:

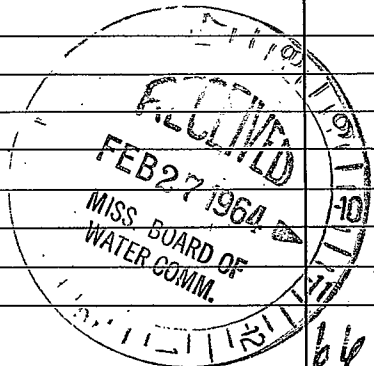

(Use Back Side)

Well No.

1950

1950