

OL 42

5-66

WATER WELL DRILLERS LOG

CODED

Date: _____, 19____, Driller: Lamar Wells County PONTOTOC
(Name)

(1) Owner of Land: J-T-ARNOLD
(Name)
ALGOMA MISS
(Address)

(2) Location: _____ 1/4, _____ 1/4, Sec. 5 T11 R 3,
8 miles South of PONTOTOC,
(distance) (direction) (Nearest Town)

(3) Topography: _____
(Hilly) (Flat) (Level)

(4) Purpose of Well: _____
(Domestic Irrigation
Municipal, Industrial, Other)

Description & Color of Materials Sand, Clay, Red Clay, Shell, etc.	Thick-ness Feet	Depth Feet
Red CLAY	40	40
GRAY SHALE	20	60
LIMESTONE	3	90
BLUE SHALE	30	120
SAND	60	180

Information upon completion of well:

(1) Diameter 4 inches.

(2) Total Depth 180 feet.

(3) Water Level 90 feet below top of ground.

(4) Cased to 118', Size 4"

(5) Screen: Size _____, Length _____.


(6) Were any formations sealed against pollution?
____ yes, ____ no.

If YES depth of formation _____

Why _____

Drillers Remarks: _____

CODED

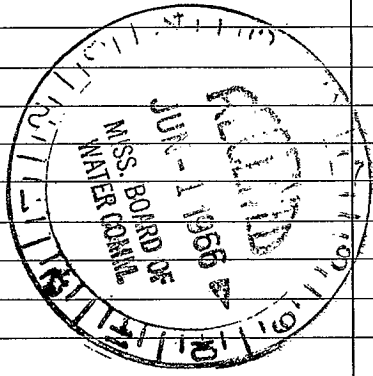

(Use Back Side)

Well No.

1953

1953

1953