

**PONTOTOC**  
**L 43**  
**5-10-72**

MISSISSIPPI  
 BOARD OF WATER COMMISSIONERS  
 416 North State Street  
 Jackson, Mississippi 39201

WATER WELL DRILLERS LOG

5-10-1972 Leaped Drilling Co - Pontotoc  
 date well completed firm name county well located


LANDOWNER:	description of formations encountered	from	to
<u>Bobby Edwards</u> <u>Rt 4 - Pontotoc,</u> (mailing address)			
WELL LOCATION:			
sec. <u>27</u> T. <u>11</u> N. R. <u>3</u> E <u>8</u> miles <u>SE</u> of <u>Pontotoc</u> (distance) (direction) (nearest town)			
WELL PURPOSE: <u>home</u> (home, irrigation, municipal, industrial)			
WELL COMPLETION DATA:			
(1) diameter (inches) <u>4</u>			
(2) total depth (feet) <u>185</u>			
(3) static water level (feet) <u>80</u> below above top of ground.			
(4) casing <u>steel</u> , <u>84</u> (material) (depth)			
(size) if telescope see back.			
(5) screen <u>none</u> (length) (depth to top)			
(size) (material)			
(6) pump <u>1/2</u> <u>7</u> (HP) (yield gpm)			
<u>Elect</u> (type power)			
(7) electric log <u>no</u> (yes or no)			
(organization running log)			
(8) how well bottom plugged <u>open</u>			
DRILLERS REMARKS:			

INDEXED 10 3077  
 JUL 1 1972

MIS.  
 W/S

If well telescopes please sketch and show depths.

GROUND LEVEL

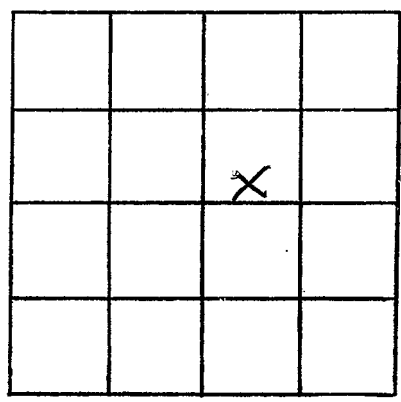

SECTION \_\_\_\_\_

Please indicate well location X.

ADDITIONAL INFORMATION

Lined area for additional information.

If more than one screen, show locations of each on sketch.