

**MISSISSIPPI
BOARD OF WATER COMMISSIONERS**
416 North State Street
Jackson, Mississippi 39201

CODED

WATER WELL DRILLERS LOG

Pontotoc
L46
5/31/79
ELog # 51

31 May 1979 19 Herndon Well & Supply, Inc. Pontotoc
date well completed firm name county well located

LANDOWNER: MS State Univ. Pontotoc Branch Experiment Sta. Pontotoc, MS 38863 (mailing address)	description of formations encountered	from	to
	Surface Clay	0	15
	Tight Sandy Clay	15	28
	Blue Clay	28	105
	Sand	105	168
	Sandy Clay	168	175
	Sand	175	195
	Sandy Clay	195	280
	Blue Clay	280	340

WELL LOCATION:
sec. 08 T1 N R. 03 E
S W
2 miles South of Pontotoc
(distance) (direction) (nearest town)

WELL PURPOSE: irrigation
(home, irrigation, municipal, industrial)

WELL COMPLETION DATA:

- (1) diameter (inches) 6" x 3"
- (2) total depth (feet) 190'
- (3) static water level (feet) 47' below ~~surface~~
top of ground.
- (4) casing Steel 140'
(material) (depth)
3" if telescope see back.
(size)
- (5) screen 40'
(length) (depth to top)
6" Stainless Steel
(size) (material)
- (6) pump 2 34.17
(HP) (yield gpm)
electric
(type power)
- (7) electric log yes
(yes or no)
Herndon Well & Supply, Inc.
(organization running log)
- (8) how well bottom plugged 3" BWV

CODED

Miss. Board of Water Comm.

JUN 14 1979


DRILLERS REMARKS:

RECEIVED

①

If well telescopes please sketch and show depths.

GROUND LEVEL

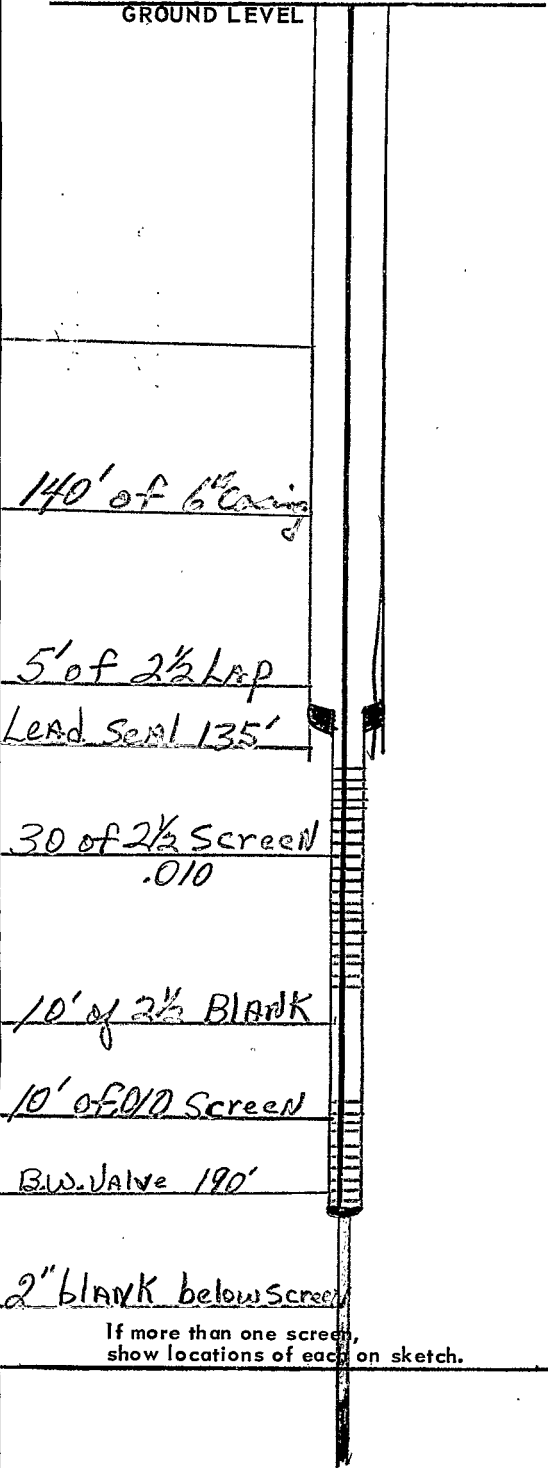

140' of 6" casing

5' of 2 1/2" Lap

Lead Seal 135'

30' of 2 1/2" Screen
.010


10' of 2 1/2" BLANK

10' of .010 Screen

B.W. VALVE 190'

2" BLANK below Screen

If more than one screen, show locations of each on sketch.

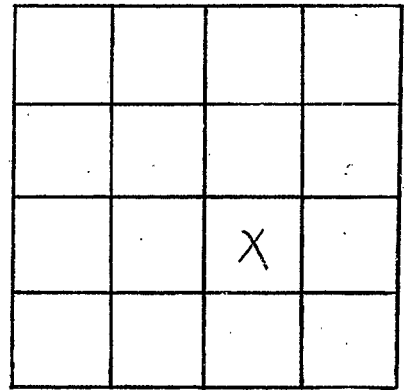

SECTION 08

Please indicate well location X.

ADDITIONAL INFORMATION

Blank lined area for additional information.