

PONTIAC
 62000
 2-20-76

MISSISSIPPI
 BOARD OF WATER COMMISSIONERS
 416 North State Street
 Jackson, Mississippi 39201

WATER WELL DRILLERS LOG

Herman Homan Well & Supply, Inc.

P.O. Box 42
 SHANNON, MISSISSIPPI 38868

2/20 1976
 date well completed


Pontiac
 county well located

LANDOWNER:	description of formations encountered	from	to
Training Tr by Rt. Pontiac, Miss. (mailing address)	Surface sand & clay Blue clay Sand Both	0 16 60 60 180	16 60 180
WELL LOCATION: sec. <u>14</u> T. <u>11</u> N. R. <u>3</u> E. S. <u>4</u> <u>5</u> miles <u>West</u> of <u>Troy</u> (distance) (direction) of (nearest town)			
WELL PURPOSE: <u>Home</u> (home, irrigation, municipal, industrial)			
WELL COMPLETION DATA:			
(1) diameter (inches) <u>4"</u>			
(2) total depth (feet) <u>180</u>			
(3) static water level (feet) <u>19'</u> below above top of ground.			
(4) casing <u>Steel</u> , <u>21'</u> , (material) (depth) <u>4"</u> (size) if telescope see back.			
(5) screen <u>no</u> , (length) (depth to top) (size) (material)			
(6) pump <u>1/2</u> <u>5</u> (HP) (yield gpm) <u>electric</u> (type power)			
(7) electric log <u>no</u> (yes or no)			
(organization running log)			
(8) how well bottom plugged <u>yes</u>			
DRILLERS REMARKS:			

RECEIVED
 MAR 10 1976
 MISS. Bd. OF WATER COMM.

If well telescopes please sketch and show depths.

GROUND LEVEL

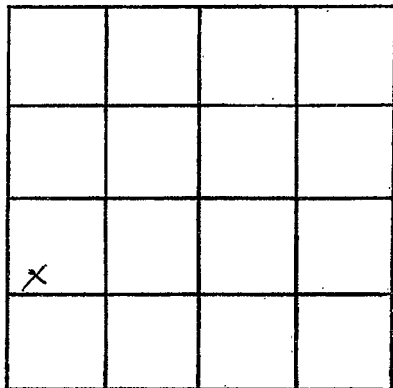

SECTION

14

Please indicate well location X.

ADDITIONAL INFORMATION

If more than one screen, show locations of each on sketch.