

PONTOTOC  
 L 2001  
 6-12-76

MISSISSIPPI  
 BOARD OF WATER COMMISSIONERS  
 416 North State Street  
 Jackson, Mississippi 39201

WATER WELL DRILLERS LOG

6-12 1976  
 date well completed

J. W. Webb + Sons  
 firm name

Pontotoc  
 county well located

LANDOWNER: Joe Sansing  
 Houka miss

description of formations encountered	from	to
Soil	0	2
Red Clay Shale	2	30
Sand & Rock	30	55
Blue Rock	55	80
Sand & Blue Rock	80	200

(mailing address)

WELL LOCATION:

sec 18 T 11 N R 3 E  
 3 1/2 miles north of Houka  
 (distance) (direction) (nearest town)

WELL PURPOSE:

(home, irrigation, municipal, industrial)

WELL COMPLETION DATA:

- (1) diameter (inches) 4
- (2) total depth (feet) 200
- (3) static water level (feet) 60 below above top of ground.
- (4) casing steel, 6.34" (material) (depth)  
 4" (size) if telescope see back.
- (5) screen 0 (length) 0 (depth to top)  
 0 (size) 0 (material)
- (6) pump 1 HP 6 (type power) (yield gpm)
- (7) electric log no (yes or no)

(organization running log)

(8) how well bottom plugged Open


DRILLERS REMARKS:

JUN 25 1976

Miss. Bd. of Water

If well telescopes please sketch and show depths.

GROUND LEVEL

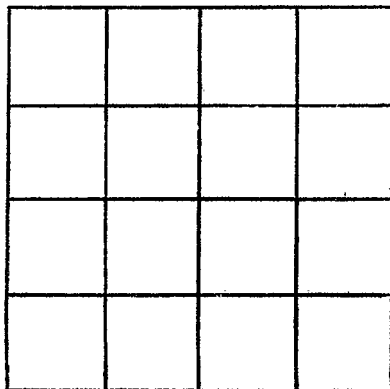

SECTION \_\_\_\_\_

Please indicate well location X.

ADDITIONAL INFORMATION

If more than one screen,  
show locations of each on sketch.