

Pontotoc  
 L 2002  
 8-20-77

MISSISSIPPI  
 BOARD OF WATER COMMISSIONERS  
 416 North State Street  
 13E Jackson, Mississippi 39201

WATER WELL DRILLERS LOG

8-20-77 date well completed  
 19 77 Herman Homan Well & Supply, Inc.  
 firm name

Pontotoc

SHANNON, MISSISSIPPI 38868

county well located


LANDOWNER:	description of formations encountered	from	to
David Warren Rt. 1 Pontotoc, Ms. (mailing address)			
WELL LOCATION: sec. <u>15</u> T. <u>11</u> N. R. <u>3</u> E. <u>3</u> miles <u>East</u> of <u>Waltham</u> (distance) (direction) (nearest town)			
WELL PURPOSE: (home, irrigation, municipal, industrial)			
WELL COMPLETION DATA:			
(1) diameter (inches) <u>4 1/2</u>			
(2) total depth (feet) <u>180</u>			
(3) static water level (feet) <u>50</u> below top of ground.			
(4) casing <u>Steel</u> <u>326'</u> (material) (depth) <u>4 1/2"</u> (size) If telescope see back.			
(5) screen <u>NO</u> (length) (depth to top) (size) (material)			
(6) pump <u>1/2</u> <u>5</u> (HP) (yield gpm) <u>electric</u> (type power)			
(7) electric log <u>NO</u> (yes or no) (organization running log)			
(8) how well bottom plugged <u>Open</u>			

RECEIVED  
 SEP - 7 1977

DRILLERS REMARKS:

If well telescopes please  
sketch and show depths.

GROUND LEVEL

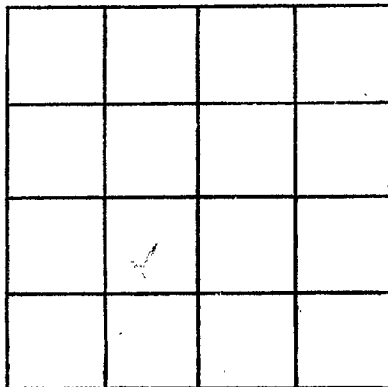

SECTION B-

Please indicate well location X.

ADDITIONAL INFORMATION

If more than one screen,  
show locations of each on sketch.