

PONTOTOC
L 2004
10-18-78

**MISSISSIPPI  
BOARD OF WATER COMMISSIONERS**  
416 North State Street  
Jackson, Mississippi 39201

**WATER WELL DRILLERS LOG**

10-18-1978 *Leaper* Pontotoc  
 date well completed firm name county well located

LANDOWNER: *Edward Brown*  
*Rt. 3 Box 19*  
*Haskell, Mo.*  
 (mailing address)

description of formations encountered	from	to
	<i>Top sand</i>	<i>0</i>
<i>Blue clay</i>	<i>20</i>	<i>90</i>
<i>Sand &amp; Rock</i>	<i>90</i>	<i>165</i>

WELL LOCATION:  
 sec. *33* T *11* N R. *3 E*  
*15* miles *S* of *Pontotoc*  
 (distance) (direction) (nearest town)

WELL PURPOSE: *Home*  
 (home, irrigation, municipal, industrial)

- WELL COMPLETION DATA:
- (1) diameter (inches) 4
  - (2) total depth (feet) 165'
  - (3) static water level (feet) 90 below above top of ground.
  - (4) casing PVC 84  
 (material) (depth)  
 \_\_\_\_\_ if telescope see back.  
 (size)
  - (5) screen \_\_\_\_\_  
 (length) (depth to top)  
 \_\_\_\_\_  
 (size) (material)
  - (6) pump 1 10  
 (HP) (yield gpm)  
Elec  
 (type power)
  - (7) electric log no  
 (yes or no)  
 \_\_\_\_\_  
 (organization running log)
  - (8) how well bottom plugged open

Miss. Board of Water Comm.


FEB 16 1979

**RECEIVED**

DRILLERS REMARKS:

If well telescopes please sketch and show depths.

GROUND LEVEL

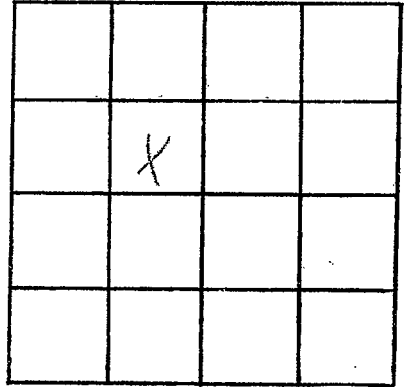

SECTION 2 11

Please indicate well location X.

ADDITIONAL INFORMATION

If more than one screen, show locations of each on sketch.