

**PONTOTOC**  
**L 2005**  
**3-1-79**

**MISSISSIPPI**  
**BOARD OF WATER COMMISSIONERS**  
 416 North State Street  
 Jackson, Mississippi 39201

**WATER WELL DRILLERS LOG**

3-1 1979 Leeper Pontotoc  
 date well completed firm name county well located

LANDOWNER: <u>David Weber</u>	description of formations encountered	from	to
<u>Jewish Church Road</u> <u>Rt. 4 Pontotoc</u> (mailing address)			
	<u>Top clay</u>	<u>0</u>	<u>10</u>
	<u>Red sand</u>	<u>10</u>	<u>40</u>
	<u>Blue Clay</u>	<u>40</u>	<u>100</u>
	<u>White sand</u>	<u>100</u>	<u>160</u>

**WELL LOCATION:**  
 sec. 16 T 11 N R 3 E  
 S W  
8 miles SE of Pontotoc  
 (distance) (direction) (nearest town)

**WELL PURPOSE:** Home  
 (home, irrigation, municipal, industrial)

- WELL COMPLETION DATA:**
- (1) diameter (inches) 4
  - (2) total depth (feet) 160
  - (3) static water level (feet) 60 <sup>below</sup> above top of ground.
  - (4) casing PVC 150  
 (material) (depth)  
 \_\_\_\_\_ if telescope see back.  
 (size)
  - (5) screen 10 150'  
 (length) (depth to top)  
4 PVC  
 (size) (material)
  - (6) pump 1HP 10  
 (HP) (yield gpm)  
Elec  
 (type power)
  - (7) electric log No  
 (yes or no)  
 \_\_\_\_\_  
 (organization running log)
  - (8) how well bottom plugged Back  
wash valve

Miss. Board of Water Comm.


JUN - 4 1979

**DRILLERS REMARKS:**

**RECEIVED**

If well telescopes please sketch and show depths.

GROUND LEVEL

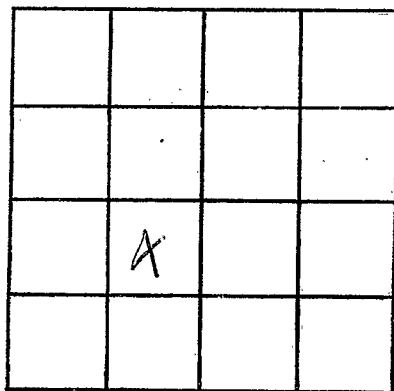

SECTION 16

Please indicate well location X.

ADDITIONAL INFORMATION

If more than one screen, show locations of each on sketch.