

MISSISSIPPI DEPARTMENT OF NATURAL RESOURCES

Bureau of Land and Water Resources

Southport Mall

P.O. Box 10631

Jackson, Mississippi 39209

WATER WELL DRILLERS LOG

PONTOTOC
L 2000
10-23-81

10-23 1981 LEEPER Drilling Pontotoc
 date well completed firm name county well located

LANDOWNER:
Mattie Williams
Hiway 15 South Pontotoc
 (mailing address)

description of formations encountered	from	to
<u>Top clay</u>	<u>0</u>	<u>15</u>
<u>Red sand</u>	<u>15</u>	<u>30</u>
<u>Blue clay</u>	<u>30</u>	<u>80</u>
<u>Coarse sand and shell</u>	<u>80</u>	<u>135</u>

WELL LOCATION:
 sec. 9 T. 11 N. R. 3 E.
7 miles S of Pontotoc
 (distance) (direction) (nearest town)

WELL PURPOSE: Home
 (home, irrigation, municipal, industrial)

WELL COMPLETION DATA:

(1) diameter (inches) 4

(2) total depth (feet) 135

(3) static water level (feet) 85 below top of ground.

(4) casing PVC 125
 (material) (depth)

4 If telescope see back.
 (size)

(5) screen 10 125
 (length) (depth to top)

4 PVC
 (size) (material)

(6) pump 1 5
 (HP) (yield gpm)

electric
 (type power)

(7) electric log NO
 (yes or no)

(organization running log)

(8) how well bottom plugged CAP


DRILLERS REMARKS:

DEPT. OF NATURAL RESOURCES
 BUREAU OF LAND & WATER RESOURCES

OCT 27 1981
 RECEIVED

If well telescopes please
sketch and show depths.

GROUND LEVEL

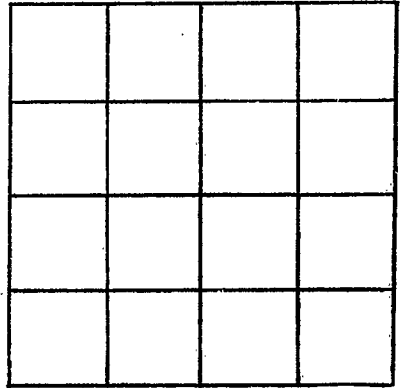

SECTION _____

Please indicate well location X.

ADDITIONAL INFORMATION

If more than one screen,
show locations of each on sketch.