

MISSISSIPPI DEPARTMENT OF NATURAL RESOURCES

Bureau of Land and Water Resources

Southport Mall

P.O. Box 10631

Jackson, Mississippi 39209

WATER WELL DRILLERS LOG

Pontotoc
 L 2007

9-3-1982 *Leeper Drilling* *Pontotoc*
 date well completed firm name county well located

LANDOWNER: *LAMANA*
Williams
 15 SOUTH PONTOTOC MS.
 (mailing address)

description of formations encountered	from	to
<i>Top clay</i>	0	20
<i>Blue clay</i>	20	40
<i>Red sand</i>	40	60
<i>WATER BEARING SAND</i>	60	82

WELL LOCATION:
 sec. *21* T. *11* N. R. *3* E
7 miles *SE* of *Pontotoc*
 (distance) (direction) (nearest town)

WELL PURPOSE:
 (home, irrigation, municipal, industrial)

- WELL COMPLETION DATA:
- (1) diameter (inches) *4*
 - (2) total depth (feet) *82*
 - (3) static water level (feet) *35* below top of ground.
 - (4) casing *PVC* *72'*
 (material) (depth)
4" If telescope see back.
 (size)
 - (5) screen *10'* *72'*
 (length) (depth to top)
4" *PVC*
 (size) (material)
 - (6) pump *ROD* *3*
 (HP) (yield gpm)
Electric
 (type power)
 - (7) electric log *NO*
 (yes or no)
 - (8) how well bottom plugged *Well*
CAJ


DRILLERS REMARKS:

DEPT. OF NATURAL RESOURCES
 BUREAU OF LAND & WATER RESOURCES

DEC - 6 1982
 RECEIVED

If well telescopes please sketch and show depths.

GROUND LEVEL

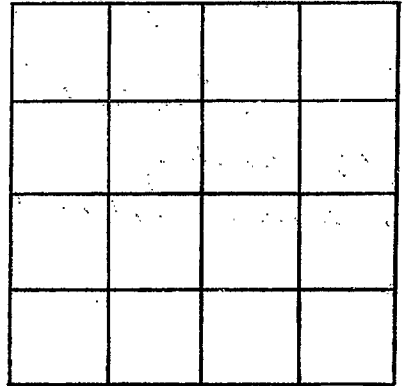

SECTION _____

Please indicate well location X.

ADDITIONAL INFORMATION

If more than one screen, show locations of each on sketch.