

**MISSISSIPPI  
BOARD OF WATER COMMISSIONERS  
416 North State Street  
Jackson, Mississippi 39201**

**WATER WELL DRILLERS LOG**

*Pontotoc*  
*L 200A*

*Nov*

19 *84* *Leeper Drilling*

*Pontotoc*

date well completed

firm name

county well located

LANDOWNER: *Steve Williams*

*Toxish Church Road*  
*Pontotoc MS -*  
(mailing address)

description of formations encountered

from to

<i>Red clay</i>	<i>0</i>	<i>10</i>
<i>Red sand</i>	<i>10</i>	<i>4.5</i>
<i>Blue clay</i>	<i>45</i>	<i>70</i>
<i>Rock and coarse sand</i>	<i>70</i>	<i>95</i>

WELL LOCATION:

sec. *25* T. *11* N. R. *3* E.  
*Toxish Church Road*  
miles (distance) (direction) (nearest town)

WELL PURPOSE:

(home, irrigation, municipal, industrial)

WELL COMPLETION DATA:

- (1) diameter (inches) *4 1/2*
- (2) total depth (feet) *95*
- (3) static water level (feet) *65* below above top of ground.
- (4) casing *PVC* *85'*  
(material) (depth)  
*4"* if telescope see back.  
(size)
- (5) screen *10'* *85'*  
(length) (depth to top)  
*4"* *PVC*  
(size) (material)
- (6) pump *1* *7*  
(HP) (yield gpm)  
*Electric*  
(type power)
- (7) electric log *NO*  
(yes or no)  
  
(organization running log)


(8) How well bottom plugged  
*Backwash Valve*

DRILLERS REMARKS:

MISS. DEPT. OF NATURAL RESOURCES  
BUREAU OF LAND & WATER RESOURCES  
NOV 29 1984  
**RECEIVED**

If well telescopes please  
sketch and show depths.

GROUND LEVEL

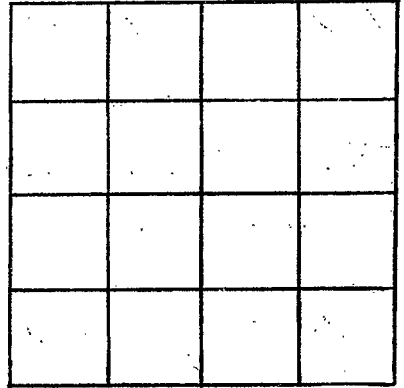

SECTION \_\_\_\_\_

Please indicate well location X.

ADDITIONAL INFORMATION

If more than one screen,  
show locations of each on sketch.