

MISSISSIPPI DEPARTMENT OF NATURAL RESOURCES

Bureau of Land and Water Resources

Southport Mall

P.O. Box 10631

Jackson, Mississippi 39209

WATER WELL DRILLERS LOG

PONTOTOC
L 2010

March 19 86 LEEPER Drilling Pontotoc
date well completed firm name county well located

LANDOWNER: Charles Foster
Rt 4 Pontotoc, MS.
(mailing address)

description of formations encountered	from	to
TOP clay	0	20
Red Sand	20	40
Blue clay	40	90
White Sand	90	140

WELL LOCATION:
sec. 9 T 11 N R 3 E
S W
1/2 miles S of Pontotoc
(distance) (direction) (nearest town)

WELL PURPOSE: Home
(home, irrigation, municipal, industrial)

- WELL COMPLETION DATA:
- (1) diameter (inches) 4"
 - (2) total depth (feet) 140 ft
 - (3) static water level (feet) 95 below top of ground.
 - (4) casing PVC 130 ft (material) (depth)
4" (size) if telescope see back.
 - (5) screen 10' 130' (length) (depth to top)
4" (size) PVC (material)
 - (6) pump 3/4 10 (HP) (yield gpm)
elec (type power)
 - (7) electric log NO (yes or no)
- (organization running log)

(8) how well bottom plugged BACK - WASH VALVE


DRILLERS REMARKS:

RECEIVED
APR 4 1986

Department of Natural Resources
Bureau of Land Resources

If well telescopes please
sketch and show depths.

GROUND LEVEL

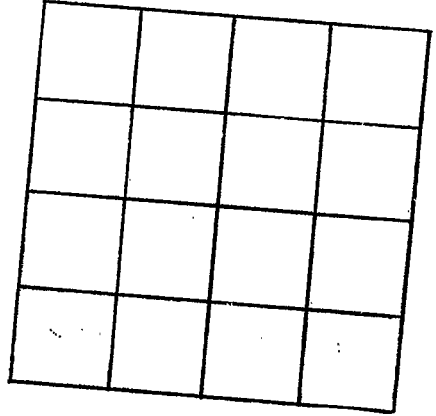

SECTION _____

Please indicate well location X.

ADDITIONAL INFORMATION

If more than one screen,
show locations of each on sketch.