

MISSISSIPPI DEPARTMENT OF NATURAL RESOURCES

Bureau of Land and Water Resources

Southport Mall

P.O. Box 10631

Jackson, Mississippi 39209

WATER WELL DRILLERS LOG

Pontotoc
L 2013

MAY 19 87 LEEPER Drilling Pontotoc
 date well completed firm name county well located

LANDOWNER: Jeff Williams
Toxish Church Rd
Pontotoc Ms.
 (mailing address)

description of formations encountered	from	to
<u>TOP CLAY</u>	<u>0</u>	<u>20</u>
<u>RED SAND</u>	<u>20</u>	<u>60</u>
<u>BLUE CLAY</u>	<u>60</u>	<u>90</u>
<u>SAND</u>	<u>90</u>	<u>140</u>

WELL LOCATION:
 sec. 15 T. 11 N. R. 3 E
 (distance) (direction) (nearest town)

WELL PURPOSE: HOME
 (home, irrigation, municipal, industrial)

WELL COMPLETION DATA:

- (1) diameter (inches) 4"
- (2) total depth (feet) 140
- (3) static water level (feet) 75 below above top of ground.
- (4) casing PVC 130
 (material) (depth)
4" if telescope see back.
 (size)
- (5) screen 10' 130
 (length) (depth to top)
4" PVC
 (size) (material)
- (6) pump 1 8
 (HP) (yield gpm)
- (7) electric log NO
 (yes or no)

RECEIVED
 JUN 17 1987


(organization running log)
 (8) how well bottom plugged back-wash valve

DRILLERS REMARKS:

Department of Natural Resources
 Bureau of Land and Water Resources

If well telescopes please
sketch and show depths.

GROUND LEVEL

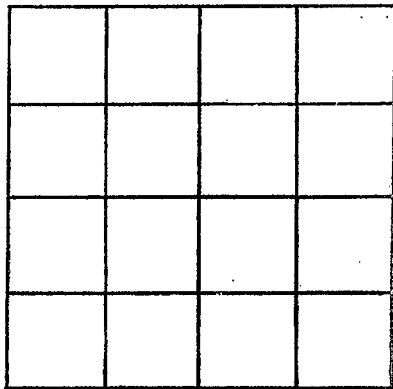

SECTION _____

Please indicate well location X.

ADDITIONAL INFORMATION

If more than one screen,
show locations of each on sketch.