

**MISSISSIPPI DEPARTMENT OF NATURAL RESOURCES**  
**Bureau of Land and Water Resources**  
 Southport Mall  
 P.O. Box 10631  
 Jackson, Mississippi 39209  
**WATER WELL DRILLERS LOG**

Pontotoc  
L 2014

Sept 1987 Leeper Drilling Co. Pontotoc  
 date well completed firm name county well located

LANDOWNER: Leon Watson  
Redland Road RT 4  
Pontotoc MS  
 (mailing address)

description of formations encountered	from	to
	<u>TOP CLAY</u>	<u>0</u>
<u>RED SAND</u>	<u>20</u>	<u>60</u>
<u>BLUE CLAY SAND</u>	<u>60</u>	<u>100</u>
	<u>100</u>	<u>160</u>

WELL LOCATION:  
 sec. 27 11 N R. 3 E  
9 miles S of Pontotoc  
 (distance) (direction) (nearest town)

WELL PURPOSE: Home  
 (home, irrigation, municipal, industrial)

WELL COMPLETION DATA:

(1) diameter (inches) 4"

(2) total depth (feet) 160 ft

(3) static water level (feet) 105 below top of ground.

(4) casing PVC, 150,  
 (material) (depth)  
4" if telescope see back.  
 (size)

(5) screen 10', 150',  
 (length) (depth to top)  
4", PVC  
 (size) (material)

(6) pump 1, 7  
 (HP) (yield gpm)  
Elec  
 (type power)

(7) electric log NO  
 (yes or no)

(organization running log)

**RECEIVED**

SEP 10 1987


Department of Natural Resources  
 Bureau of Land & Water Resources

(8) how well bottom plugged Back-  
Wash Water

DRILLERS REMARKS:

If well telescopes please  
sketch and show depths.

GROUND LEVEL

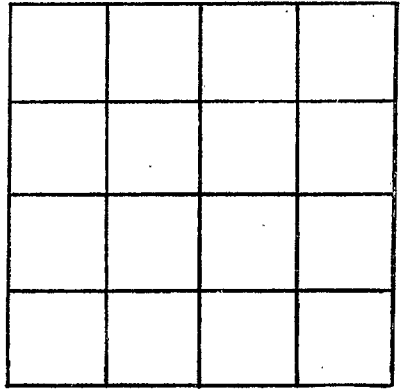

SECTION \_\_\_\_\_

Please indicate well location X.

ADDITIONAL INFORMATION

If more than one screen,  
show locations of each on sketch.