

MISSISSIPPI DEPARTMENT OF NATURAL RESOURCES

Bureau of Land and Water Resources

Southport Mall

P.O. Box 10631

Jackson, Mississippi 39209

WATER WELL DRILLERS LOG

PONTOTOC  
L 2015

Sept 19 87 date well completed      Leeper Drilling Co. firm name      Pontotoc county well located


LANDOWNER: Ricky Collins  
Redland Rd Rt 4  
Pontotoc MS  
(mailing address)

description of formations encountered	from	to
<u>TOP CLAY</u>	<u>0</u>	<u>20</u>
<u>RED SAND</u>	<u>20</u>	<u>60</u>
<u>BLUE CLAY</u>	<u>60</u>	<u>100</u>
<u>SAND</u>	<u>100</u>	<u>160</u>

WELL LOCATION:  
sec. 27 T. 11 N. R. 3 (E)  
9 miles S of Pontotoc  
(distance) (direction) (nearest town)

WELL PURPOSE: HOME  
(home, irrigation, municipal, industrial)

- WELL COMPLETION DATA:
- (1) diameter (inches) 4"
  - (2) total depth (feet) 160'
  - (3) static water level (feet) 100 <sup>below</sup>/<sub>above</sub> top of ground.
  - (4) casing PVC, 150'  
(material) (depth)  
4" if telescope see back.  
(size)
  - (5) screen 10', 150'  
(length) (depth to top)  
4", PVC  
(size) (material)
  - (6) pump 1, 7  
(HP) (yield gpm)  
Elec  
(type power)
  - (7) electric log NO  
(yes or no)

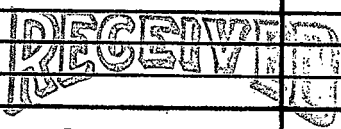

SEP 10 1987


Department of Natural Resources  
Bureau of Land & Water Resources

(organization running log)  
(8) how well bottom plugged Back  
WASH VALVE

DRILLERS REMARKS:

If well telescopes please  
sketch and show depths.

GROUND LEVEL

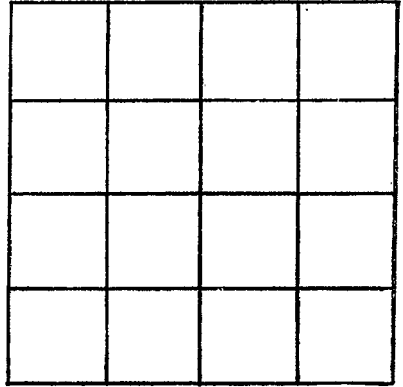

SECTION \_\_\_\_\_

Please indicate well location X.

ADDITIONAL INFORMATION

If more than one screen,  
show locations of each on sketch.