

Pontotoc  
L 2016

MISSISSIPPI  
BOARD OF WATER COMMISSIONERS  
416 North State Street  
Jackson, Mississippi 39201

WATER WELL DRILLERS LOG

8-27 1987 T.M. Parks Drlg. Co. Pontotoc  
date well completed firm name county well located

LANDOWNER: Edward C. Brown  
Rt. 3 Box 238  
Houlka, MS 38850  
(mailing address)

WELL LOCATION:  
sec. 33 T. 11 N. R. 3 E  
S W  
1/2 miles N of Houlka  
(distance) (direction) (nearest town)

WELL PURPOSE: home  
(home, irrigation, municipal, industrial)

WELL COMPLETION DATA:  
(1) diameter (inches) 4  
(2) total depth (feet) 1060  
(3) static water level (feet) 247 below above top of ground.  
(4) casing steel 450 (material) (depth)  
2" - if telescope see back. (size)  
(5) screen 80' 990' (length) (depth to top)  
2" steel slot (size) (material)  
(6) pump 3/4 5 (HP) (yield gpm).  
SF (type power)  
(7) electric log NO (yes or no)  
(organization running log)

(8) how well bottom plugged - BPV w/nipple @ 1062 TD

description of formations encountered	from	to
Topsoil	0	44
sandy clay & shale	44	97
red sand	97	140
sandy shale & limestone	140	208
limestone clays	208	740
sandy clays & shales	740	980
sand & shale	980	1068


RECEIVED  
SEP 23 1987

Department of Natural Resources  
Bureau of Land & Water Resources

DRILLERS REMARKS: water is good, clear; water comes from very fine sand and shale. 6 to 8 thousands sand size

If well telescopes please sketch and show depths.

GROUND LEVEL

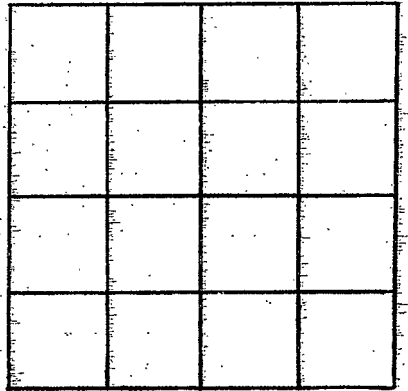

SECTION \_\_\_\_\_

Please indicate well location X.

ADDITIONAL INFORMATION

If more than one screen, show locations of each on sketch.