

PONTOTOC  
 L 207

MISSISSIPPI  
 BOARD OF WATER COMMISSIONERS  
 416 North State Street  
 Jackson, Mississippi 39201

WATER WELL DRILLERS LOG

June 1988 LEEPER Drilling Pontotoc  
 date well completed firm name county well located

LANDOWNER: Joyce Monts  
 Toxish Road  
 Pontotoc  
 (mailing address)

WELL LOCATION:  
 sec. 22 T. 11 N. R. 3 E.  
 8 miles SE of Pontotoc  
 (distance) (direction) (nearest town)

WELL PURPOSE: Home  
 (home, irrigation, municipal, industrial)

- WELL COMPLETION DATA:
- (1) diameter (inches) 4"
  - (2) total depth (feet) 95'
  - (3) static water level (feet) 70' <sup>below</sup>/<sub>above</sub> top of ground
  - (4) casing PVC 85'  
 (material) (depth)  
 4" if telescope see back.  
 (size)
  - (5) screen 10' 85'  
 (length) (depth to top)  
 4" PVC  
 (size) (material)
  - (6) pump 3/4 10  
 (HP) (yield gpm)  
 Elec  
 (type power)
  - (7) electric log \_\_\_\_\_  
 (yes or no)
- \_\_\_\_\_  
 (organization running log)

description of formations encountered	from	to
TOP clay	0	10
Red sand	10	30
Blue clay	30	70
COARSE Red sand	70	95


RECEIVED  
 AUG 11 1988

Department of Natural Resources  
 Bureau of Land & Water Resources

(8) how well bottom plugged  
 Back wash valve  
 DRILLERS REMARKS:

If well telescopes please sketch and show depths.

GROUND LEVEL

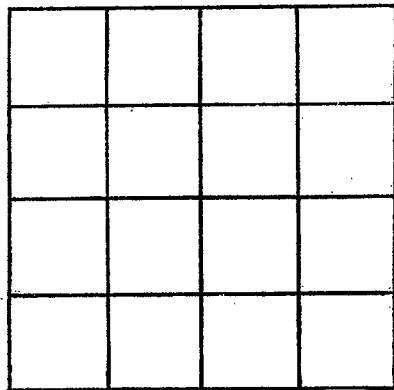

SECTION \_\_\_\_\_

Please indicate well location X.

ADDITIONAL INFORMATION

If more than one screen,  
show locations of each on sketch.