

Pontotoc
M14
3-11-70

MISSISSIPPI
BOARD OF WATER COMMISSIONERS
416 North State Street
Jackson, Mississippi 39201

CODED

WATER WELL DRILLERS LOG

Shannon-Homan Well & Supply, Inc.

P.O. Box 42

Pontotoc

3-11 1970

date well completed

SHANNON, MISSISSIPPI 39068

county well located

LANDOWNER: Louis Fleming

description of formations encountered

from to

Sand & clay	0	35
Blue clay	35	562
Sand	562	700
Bottom	700	

Jupelo, Miss.
(mailing address)

WELL LOCATION:

sec. 13 T. 11 R. 4
6 miles West of Shannon
(distance) (direction) (nearest town)

WELL PURPOSE: home
(home, irrigation, municipal, industrial)

WELL COMPLETION DATA:

- diameter (inches) 5"
- total depth (feet) 700
- static water level (feet) 175 below top of ground. ~~above~~
- casing Steel, 38'
(material) (depth)
5" if telescope see back.
(size)
- screen no,
(length) (depth to top)
(size) (material)
- pump 3/4, 5
(HP) (yield gpm)
Electric
(type power)
- electric log no
(yes or no)
(organization running log)
- how well bottom plugged open

CODED


APR 13 1970

MISS. BD. OF
WATER COMMISSIONERS

DRILLERS REMARKS:

If well telescopes please sketch and show depths.

GROUND LEVEL

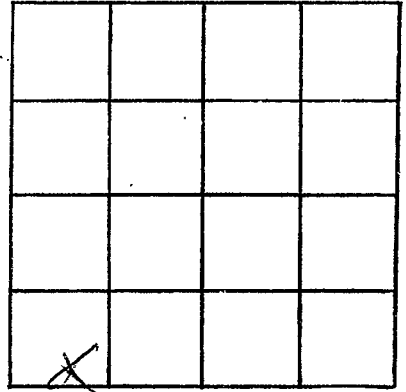

SECTION f 3

Please indicate well location X.

ADDITIONAL INFORMATION

If more than one screen,
show locations of each on sketch.