

MISSISSIPPI
BOARD OF WATER COMMISSIONERS
416 North State Street
Jackson, Mississippi 39201

CODED

WATER WELL DRILLERS LOG

PONTOTOC
M15
7-27-70

7-27 1970 Herndon-Hornau Well Pontotoc
date well completed firm name county well located

LANDOWNER: Willie Burley
102 Silver St.
Okolona, Miss 38860
(mailing address)

description of formations encountered	from	to
<u>Surface sand & clay</u>	<u>0</u>	<u>18</u>
<u>Blue clay</u>	<u>18</u>	<u>460</u>
<u>Sand</u>	<u>460</u>	<u>600</u>
<u>Bottom</u>	<u>600</u>	

WELL LOCATION:
sec. 25 T. 11 N. R. 9 E
3 1/2 miles SE of Tag
(distance) (direction) (nearest town)

WELL PURPOSE: home
(home, irrigation, municipal, industrial)

- WELL COMPLETION DATA:
- (1) diameter (inches) 5"
 - (2) total depth (feet) 600'
 - (3) static water level (feet) 123 below above top of ground.
 - (4) casing Steel 22' 4"
(material) (depth)
4"
(size) if telescope see back.
 - (5) screen no
(length) (depth to top)
(size) (material)
 - (6) pump 3/4 5
(HP) (yield gpm)
Electric
(type power)
 - (7) electric log no
(yes or no)
(organization running log)
 - (8) how well bottom plugged open


CODED

DRILLERS REMARKS:

20 1970

If well telescopes please sketch and show depths.

GROUND LEVEL

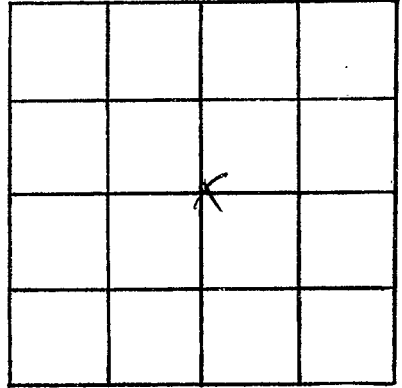

SECTION 25

Please indicate well location X.

ADDITIONAL INFORMATION

If more than one screen, show locations of each on sketch.