

PONTOTOC
M 17
6-18-71

MISSISSIPPI
BOARD OF WATER COMMISSIONERS
416 North State Street
Jackson, Mississippi 39201

CODED

WATER WELL DRILLERS LOG

Herndon-Homan Well Supply, Inc.

Pontotoc

6-18-71
date well completed

P. O. Box 42

SHANNON, MISSISSIPPI 38868 county well located

LANDOWNER: Albert Woods
Route 1
Shannon, Miss
(mailing address)

description of formations encountered	from	to
Surface sand & clay	0	38
Blue clay	38	560
Sand	560	780
Bottom	780	

WELL LOCATION:
sec. 23 T. 11 N. R. 4 E
S. 4
3.4 miles E of Troy
(distance) (direction) (nearest town)

WELL PURPOSE: Home
(home, irrigation, municipal, industrial)

- WELL COMPLETION DATA:
- (1) diameter (inches) 5"
 - (2) total depth (feet) 700'
 - (3) static water level (feet) 123 below top of ground.
 - (4) casing Steel 42'
(material) (depth)
5" if telescope see back.
(size)
 - (5) screen no
(length) (depth to top)
(size) (material)
 - (6) pump 3/4 5
(HP) (yield gpm)
electric
(type power)
 - (7) electric log no
(yes or no)
(organization running log)
 - (8) how well bottom plugged Open

CODED


JUL 12 1971

MISS. BD. OF
WATER COMM.

DRILLERS REMARKS:

If well telescopes please sketch and show depths.

GROUND LEVEL

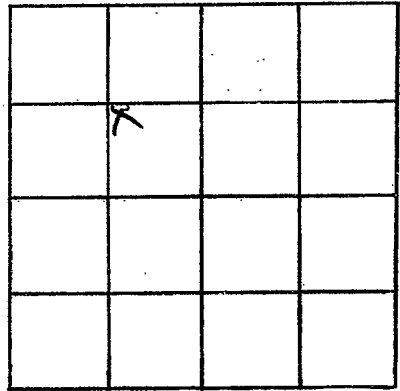

SECTION 23

Please indicate well location X.

ADDITIONAL INFORMATION

If more than one screen, show locations of each on sketch.