

Pontotoc
M-19
8-66

MISSISSIPPI BOARD OF WATER COMMISSIONERS

WATER WELL DRILLERS LOG

Pontotoc

Date: 8/1, 1966, Driller: C. W. C. C. County: Lee

(Name)

CODED

John E. Taylor
(Name)

Pontotoc
(Address)

(2) Location: 1/4, 1/4, Sec. 9, T11 R14 E
1 miles N of Troy
(distance) (direction) (Nearest Town)

(3) Topography: Hilly
(Hilly) (Flat) (Level)

(4) Purpose of Well: Domestic
(Domestic Irrigation
Municipal, Industrial, Other)

Description & Color of Materials Sand, Clay, Red Clay, Shell, etc.	Thick- ness Feet	Depth Feet
Dark Clay	0	50
Blue	50	150
Sand & Blue Clay	150	325
Blue	325	800
Gravel	800	950

Information upon completion of well:


- (1) Diameter 4 inches.
- (2) Total Depth 950 feet.
- (3) Water Level 240 feet below top of ground.
- (4) Cased to 350, Size 4
- (5) Screen: Size _____, Length _____
- (6) Were any formations sealed against pollution?
_____ yes, _____ no.

If YES depth of formation _____

Why _____

Drillers Remarks: _____

CODED

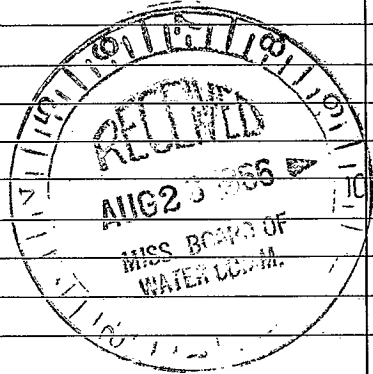

(Use Back Side)

Well No.

