

CODED

WATER WELL DRILLERS LOG

Date: 8/1, 1966, Driller: Ewing Sisco, County: Lee
 (Name)

(1) Owner of Land: TALLIE HEARD
 (Name)
Pontotoc Rt 1
 (Address)

(2) Location: 1/4, 1/4, Sec. 28 T11R4E
3 miles S of TROY
 (distance) (direction) (Nearest Town)

(3) Topography: Hilly
 (Hilly) (Flat) (Level)

(4) Purpose of Well: Domestic
 (Domestic Irrigation
 Municipal, Industrial, Other)

Description & Color of Materials Sand, Clay, Red Clay, Shell, etc.	Thick- ness Feet	Depth Feet
<u>Soft clay</u>	<u>0</u>	<u>50</u>
<u>Shale</u>	<u>50</u>	<u>250</u>
<u>Sand</u>	<u>250</u>	<u>380</u>
<u>Blue clay</u>	<u>300</u>	<u>700</u>
<u>Sand</u>	<u>700</u>	<u>842</u>

Information upon completion of well:

(1) Diameter 4 inches.

(2) Total Depth 842 feet.

(3) Water Level 240 feet below top of ground.

(4) Cased to 343 ft, Size 4 in.

(5) Screen: Size _____, Length _____


(6) Were any formations sealed against pollution?
 _____ yes, _____ no.

If YES depth of formation _____

Why _____

Drillers Remarks: _____

CODED

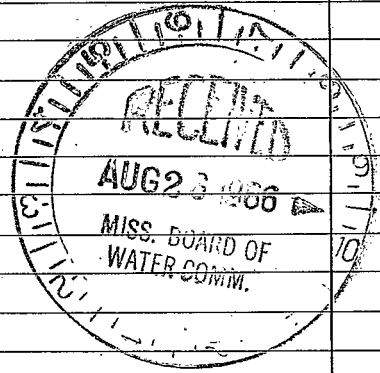

(Use Back Side)

Well No.

