

CODED

Pontotoc
M-21
2-68

MISSISSIPPI
 BOARD OF WATER COMMISSIONERS
 416 North State Street
 Jackson, Mississippi 39201

CODED

WATER WELL DRILLERS LOG

2-15- 1968 Leepel Drilling Co Pontotoc
 date well completed firm name county well located

LANDOWNER:
Danny Prater
Attn - Pontotoc
 (mailing address)

description of formations encountered	from	to
<u>Red Clay</u>	<u>0</u>	<u>30</u>
<u>Sandy clay</u>	<u>30</u>	<u>90</u>
<u>Rock + strata of</u>		
<u>Red sand</u>	<u>90</u>	<u>180</u>
<u>Porters Creek clay</u>	<u>180</u>	<u>450</u>
<u>Selma Chalk</u>	<u>450</u>	<u>800</u>
<u>Cutaw Sand</u>	<u>800</u>	<u>960</u>

WELL LOCATION:
 sec. 6 T. 11 R. 4 E.
S SE of Pontotoc
 (distance) (direction) (nearest town)

WELL PURPOSE: None
 (home, irrigation, municipal, industrial)

- WELL COMPLETION DATA:
- (1) diameter (inches) 4
 - (2) total depth (feet) 960
 - (3) static water level (feet) 180 below top of ground.
 - (4) casing Steel, 220'
 (material) (depth)
 (size) if telescope see back.
 - (5) screen no screen
 (length) (depth to top)
 (size) (material)
 - (6) pump 3/4 10
 (HP) (yield gpm)
Elect
 (type power)
 - (7) electric log no
 (yes or no)
 (organization running log)
 - (8) how well bottom plugged Open


CODED

8 1508
 MISS. Bd. OF
 WATER COMMISSIONERS

DRILLERS REMARKS:

If well telescopes please sketch and show depths.

GROUND LEVEL

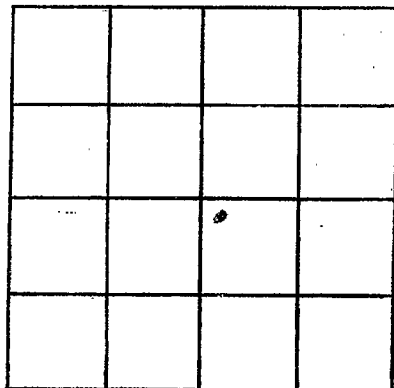

SECTION _____

Please indicate well location X.

ADDITIONAL INFORMATION

If more than one screen, show locations of each on sketch.