

CODED

CODED

MISSISSIPPI
BOARD OF WATER COMMISSIONERS
416 North State Street
Jackson, Mississippi 39201

WATER WELL DRILLERS LOG

Pontotoc
M-22
4-68

date well completed 19 *4-15-68* firm name *Leeper Drilling Co -* county well located *Pontotoc*

LANDOWNER: *Sammy Proter*

description of formations encountered	from	to
<i>Red Clay</i>	<i>0</i>	<i>30</i>
<i>Sandy clay</i>	<i>30</i>	<i>90</i>
<i>Rock, & streaks of</i>		
<i>Red sand</i>	<i>90</i>	<i>180</i>
<i>Porters Creek clay -</i>	<i>180</i>	<i>450</i>
<i>Chalk</i>	<i>450</i>	<i>800</i>
<i>Eutaw Sands</i>	<i>800</i>	<i>960</i>

Rt 1 - Pontotoc
(mailing address)

WELL LOCATION:
sec. *6* T. *11* N. R. *4* E
7 miles *S.E.* of *Pontotoc*
(distance) (direction) (nearest town)

WELL PURPOSE: *Home*
(home, irrigation, municipal, industrial)

WELL COMPLETION DATA:

- (1) diameter (inches) *4*
- (2) total depth (feet) *960*
- (3) static water level (feet) *180* below top of ground.
- (4) casing *Steel*, *220'* (material) (depth)

_____ if telescope see back.
(size)

- (5) screen *no screen* (length) (depth to top)

_____ (size) (material)

- (6) pump *3/4* *10* (HP) (yield gpm)

Elect
(type power)

- (7) electric log *no -* (yes or no)

_____ (organization running log)

- (8) how well bottom plugged *Open*


DRILLERS REMARKS: _____

CODED

JUL 5 1968
MISS. ST. CH
WATER BOARD

If well telescopes please
sketch and show depths.

GROUND LEVEL

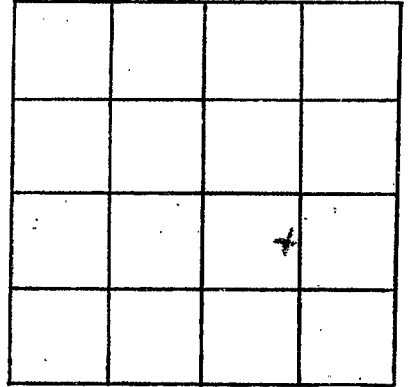

SECTION _____

Please indicate well location X.

ADDITIONAL INFORMATION

If more than one screen,
show locations of each on sketch.