

PONTOTOC

Herndon Well & Supply Co. ?

Date: 2-10-61, Driller:

SHANNON, MISS.

County Pontotoc

M23

(Name)

(1) Owner of Land: J. L. Herndon
(Name)

At Shannon, Miss
(Address)

(2) Location: 1/4, 1/4, Sec. 15 T11R4

1/2 miles East of Troy
(distance) (direction) (Nearest Town)

(3) Topography: Hilly
(Hilly) (Flat) (Level)

(4) Purpose of Well: Home use
(Domestic Irrigation
Municipal, Industrial, Other)

Information upon completion of well:

(1) Diameter 4 inches.

(2) Total Depth 760 feet.

(3) Water Level 195 feet below top of ground.

(4) Cased to 109', Size 4"

(5) Screen: Size —, Length —

(6) Were any formations sealed against pollution?

X yes, — no.

If YES depth of formation 106 ft.

Why Surface & Sand

Drillers Remarks:

Description & Color of Sand, Clay, Red Clay, Shale, etc.


CODED

Thickness Feet

Depth Feet

CLAY	10
SAND	30
Black Shell	
White Chalk	106
rock	505
gumbo	538
SAND	638
bottom	760

CODED

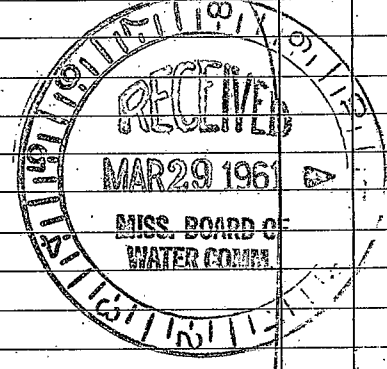

Well No.

(Use Back Side)

0300

0300