

Ponto Toc
M 24
11-24-71

MISSISSIPPI
BOARD OF WATER COMMISSIONERS
416 North State Street
Jackson, Mississippi 39201

DEC 16 1971
CODED

WATER WELL DRILLERS LOG

Herndon-Homan Well & Supply, Inc.

Ponto Toc

11/24

1971

P. O. Box 49

date well completed


SHANNON, MISSISSIPPI 38662 county well located

LANDOWNER:	description of formations encountered	from	to
William D. Spatt Rt. 1 Okolona, Miss. (mailing address)	Surface sand & clay Blue clay Sand Bottom	0 34 3760 600	34 360 600
WELL LOCATION: sec. 25 T. 11 N. R. 4 E S W 2 1/2 miles SE of Troy (distance) (direction) (nearest town)			
WELL PURPOSE: Home (home, irrigation, municipal, industrial)			
WELL COMPLETION DATA: (1) diameter (inches) 5" (2) total depth (feet) 600' (3) static water level (feet) 150' below top of ground. (4) casing steel, 37 3/4" (material) (depth) 5" if telescope see back. (size) (5) screen 20" (length) (depth to top) (size) (material) (6) pump 3/4 HP 5 (yield gpm) (HP) (type power) electric (7) electric log NO (yes or no) (organization running log) (8) how well bottom plugged open			
DRILLERS REMARKS:			

CODED

If well telescopes please sketch and show depths.

GROUND LEVEL

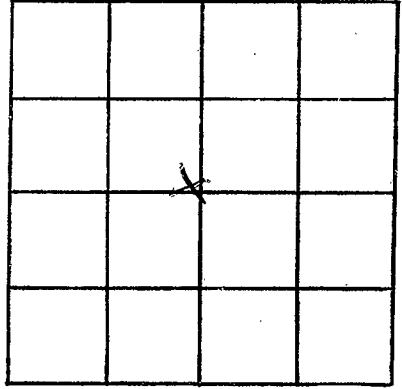

SECTION 25

Please indicate well location X.

ADDITIONAL INFORMATION

If more than one screen, show locations of each on sketch.