

BOARD OF WATER COMMISSIONERS

416 North State Street  
Jackson, Mississippi 39201

CODED

WATER WELL DRILLERS LOG

Dec. 19 76 Herndon Well & Supply, Inc. Pontotoc  
date well completed firm name county well located

LANDOWNER: Troy Water Assoc.

Route

Pontotoc, MS 38863

(mailing address)

WELL LOCATION:

sec. 22 T. 11 N. R. 04 E. SW  
S. SW  
miles E of PONTOTOC  
(distance) (direction) (nearest town)

WELL PURPOSE: Community  
(home, irrigation, municipal, industrial)

WELL COMPLETION DATA:

- (1) diameter (inches) 8 x 4
- (2) total depth (feet) 944
- (3) static water level (feet) 290 below top of ground. ~~290~~
- (4) casing Steel 864  
(material) (depth)  
8  
(size) if telescope see back.
- (5) screen 60 884  
(length) (depth to top)  
4 " Stainless  
(size) (material)
- (6) pump 30 162  
(HP) (yield gpm)  
Elec.  
(type power)
- (7) electric log yes  
(yes or no)  
USGS  
(organization running log)
- (8) how well bottom plugged BW

description of formations encountered	from	to
Red Clay	0	3
Lime Rock	3	55
Blue Sandy Clay	55	65
Blue Clay	65	115
Lime Rock	115	570
Rock	570	571
Lime Rock	571	680
Blue Sandy Clay	680	756
Sand	756	862
Rock	862	865
Sand	865	910
Blue Clay	910	916
Sand	916	940
Gray Clay	940	972
Sand	972	984
Blue Clay	984	1050
Fine Gravel	050	060
Blue Clay	060	094
Rock	094	100

CODED


RECEIVED

MAR 28 1977

DRILLERS REMARKS:

If well telescopes please sketch and show depths.

2011

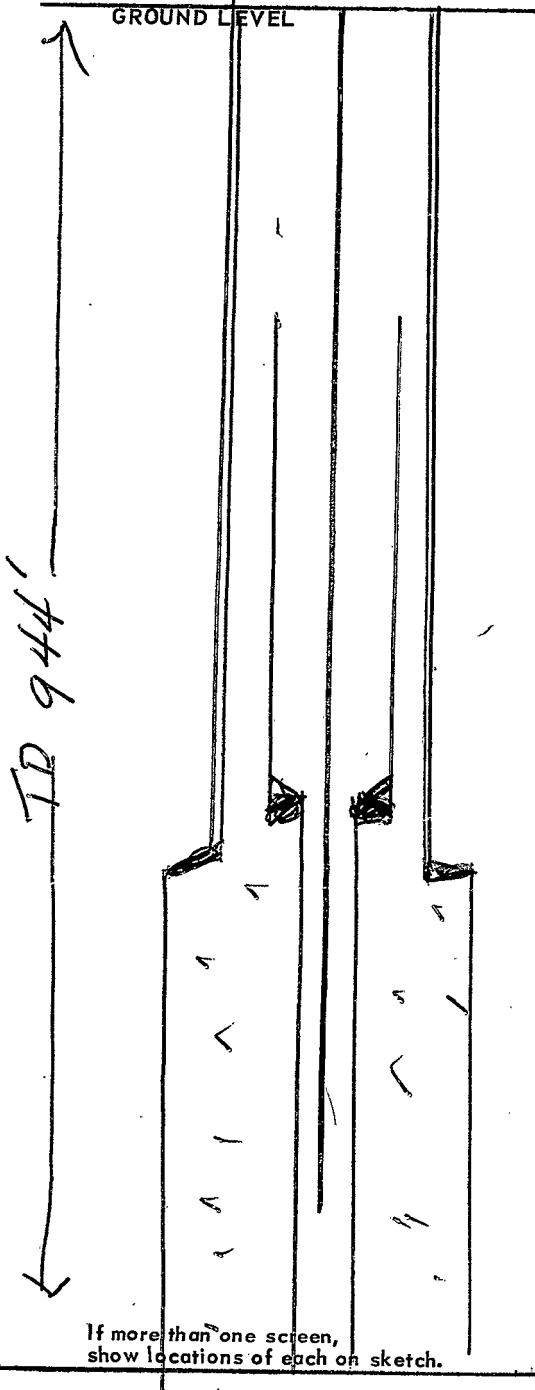

If more than one screen, show locations of each on sketch.

X			

SECTION 22

Please indicate well location X.

ADDITIONAL INFORMATION

400' Column 9"

TOP OF LAP 800

400' AIR LINE

TOP OF LAP 800'

STATIC WL 290'

162 GPM

60' SCREEN

7 CY GRAVEL