

*Quintess*  
*A 30*  
*9-22-69*

MISSISSIPPI  
 BOARD OF WATER COMMISSIONERS  
 416 North State Street  
 Jackson, Mississippi 39201

WATER WELL DRILLERS LOG

*9-22* 19*69* *Bond Well Drilling* *Prentiss*  
 date well completed firm name county well located

LANDOWNER: <i>John Perry Hill</i>	description of formations encountered	from	to
<i>Reingi</i> (mailing address)	<i>min. clay sand</i>	<i>0</i>	<i>16</i>
	<i>blue clay</i>	<i>16</i>	<i>320</i>
	<i>water sand</i>	<i>320</i>	<i>380</i>

WELL LOCATION:  
 sec. *16* T. *4* N. R. *6* E.  
*3* miles *North* of *Jackson*  
 (distance) (direction) (nearest town)

WELL PURPOSE: *Home*  
 (home, irrigation, municipal, industrial)

- WELL COMPLETION DATA:
- (1) diameter (inches) *4*
  - (2) total depth (feet) *380*
  - (3) static water level (feet) *160* ~~below~~ above top of ground.
  - (4) casing *Steel* *21*  
 (material) (depth)  
 (size) if telescope see back.
  - (5) screen *none*  
 (length) (depth to top)  
 (size) (material)
  - (6) pump *3/4* *5*  
 (HP) (yield gpm)  
*Elect. Sub.*  
 (type power)
  - (7) electric log *no*  
 (yes or no)  
 (organization running log)
  - (8) how well bottom plugged *0 none*


DRILLERS REMARKS:

107 8-150

MISSISSIPPI  
 BOARD OF WATER COMMISSIONERS  
 JACKSON, MISSISSIPPI

If well telescopes please sketch and show depths.

GROUND LEVEL

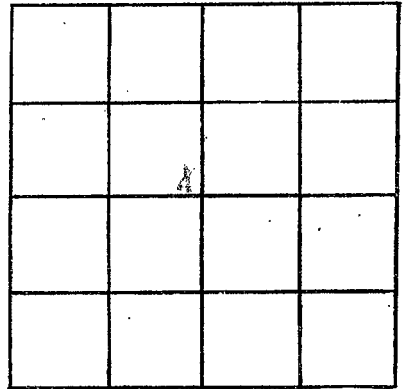

SECTION 16

Please indicate well location X.

ADDITIONAL INFORMATION

If more than one screen, show locations of each on sketch.