

CODED

MISSISSIPPI  
BOARD OF WATER COMMISSIONERS  
416 North State Street  
Jackson, Mississippi 39201

WATER WELL DRILLERS LOG

Prentiss  
A 31  
12-20-69

12-20 1969 Bond Well Drilling Prentiss  
drill well completed firm name county well located

LANDOWNER: Ronald Bridges  
R. 3  
Boonville  
(mailing address)

description of formations encountered	from	to
<u>Red sand</u>	<u>0</u>	<u>15</u>
<u>Blue clay</u>	<u>15</u>	<u>280</u>
<u>Water sand</u>	<u>280</u>	<u>340</u>

WELL LOCATION:  
sec. 33 T 4 N R 6 E  
8 miles <sup>S</sup> West of Boonville  
(distance) (direction) (nearest town)

WELL PURPOSE: Home  
(home, irrigation, municipal, industrial)

- WELL COMPLETION DATA:
- (1) diameter (inches) 4
  - (2) total depth (feet) 340
  - (3) static water level (feet) 170 <sup>below</sup> above top of ground.
  - (4) casing Steel 21  
(material) (depth)  
(size) If telescope see back.
  - (5) screen none  
(length) (depth to top)  
(size) (material)
  - (6) pump 2 4  
(HP) (yield gpm)  
Jet  
(type power)
  - (7) electric log no  
(yes or no)  
(organization running log)
  - (8) how well bottom plugged open


DRILLERS REMARKS:

JAN 5 1970

MISSISSIPPI  
BOARD OF WATER COMMISSIONERS

If well telescopes please sketch and show depths.

GROUND LEVEL

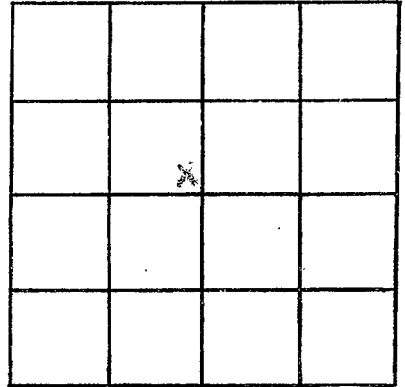

SECTION 33

Please indicate well location X.

ADDITIONAL INFORMATION

If more than one screen,  
show locations of each on sketch.