

MISSISSIPPI
BOARD OF WATER COMMISSIONERS
416 North State Street
Jackson, Mississippi 39201

CODED

WATER WELL DRILLERS LOG

PRENTISS
A 37
11-21-70

11-21 1970 Bond Well Drilling Prentiss
date well completed firm name county well located

LANDOWNER: Hershel Penning

description of formations encountered	from	to
<u>Red clay</u>	<u>0</u>	<u>18</u>
<u>Blue clay</u>	<u>18</u>	<u>210</u>
<u>Water sand</u>	<u>210</u>	<u>260</u>

Boonwell, Miss
(mailing address)

WELL LOCATION:
sec. 11 T. 4 N. R. 6 E.
7 miles N-W of Boonwell
(distance) (direction) (nearest town)

WELL PURPOSE: Home
(home, irrigation, municipal, industrial)

- WELL COMPLETION DATA:
- (1) diameter (inches) 4
 - (2) total depth (feet) 260
 - (3) static water level (feet) 120 below above top of ground.
 - (4) casing Steel, 21
(material) (depth)
 - _____ If telescope see back.
(size)
 - (5) screen none
(length) (depth to top)
 - _____ (size) _____ (material)
 - (6) pump 2 5
(HP) (yield gpm)
 - Elect.
(type power)
 - (7) electric log no
(yes or no)
 - _____ (organization running log)
 - (8) how well bottom plugged open

CODED


DEC. 7 1970

DRILLERS REMARKS:

MISS. BD. OF
WATER COMM.

If well telescopes please sketch and show depths.

GROUND LEVEL

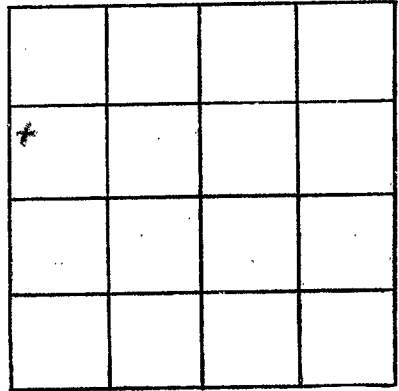

SECTION _____

Please indicate well location X.

ADDITIONAL INFORMATION

If more than one screen,
show locations of each on sketch.