

PRENTISS

A38

6-7-67

MISSISSIPPI BOARD OF WATER COMMISSIONERS 416 North State Street Jackson, Mississippi 39201

CODED

WATER WELL DRILLERS LOG

6-7

date well completed

1967 Herndon Home Well &

firm name

Prentiss

county well located

Supplier

LANDOWNER:

Jumpertown

Water District

Jumpertown, Miss (mailing address)

description of formations encountered

from

to

Red Clay

0

10

Blue Clay

10

153

Tight Sand

153

188

Sandy Blue Clay

188

330

Sand (tight)

230

280

Sand (tight) & Shale

280

368

Bummy Blue Clay

368

468

Tight Sand

468

556

Gravel

556

590

Chert & Gravel

590

620

Bottom

620

WELL LOCATION:

sec. 36 T 4 N R 6 E 2 miles E of Jumpertown (distance) (direction) (nearest town)

WELL PURPOSE: home, irrigation, municipal, industrial

WELL COMPLETION DATA:

- (1) diameter (inches) 8" x 4"
(2) total depth (feet) 620
(3) static water level (feet) 190 below top of ground
(4) casing steel, 560' (material) (depth) 8" (size) if telescope see back.
(5) screen 31' 560" (length) (depth to top) 4" stainless steel (size) (material)
(6) pump 25 (HP) 129.2 (yield gpm) Electric (type power)
(7) electric log yes (yes or no) WSS (organization running log)
(8) how well bottom plugged Backwash Valve

CODED


JAN 11 1971

DRILLERS REMARKS:

MISS. BD. OF WATER COMM.

If well telescopes please sketch and show depths.

GROUND LEVEL

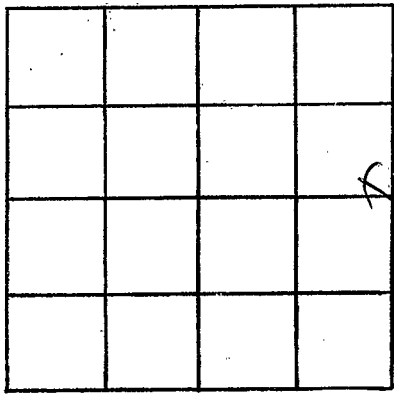

SECTION 36

Please indicate well location X.

ADDITIONAL INFORMATION

560' of
8-1/2" well
casing

31' of
4" screen

If more than one screen, show locations of each on sketch.

