

PRENTISS

A 39

5-7-71

MISSISSIPPI BOARD OF WATER COMMISSIONERS

416 North State Street

Jackson, Mississippi 39201

CODED

WATER WELL DRILLERS LOG

5-7

date well completed

1971 Bond Well Drilling

firm name

Prentiss

county well located

LANDOWNER: Edna Hurst

description of formations encountered

from to

Booneville Miss
(mailing address)

<u>Mixed sand</u>	<u>0</u>	<u>57</u>
<u>Blue clay</u>	<u>57</u>	<u>70</u>
<u>Water sand</u>	<u>70</u>	<u>105</u>

WELL LOCATION:

sec. 9 T. 4 N. R. 6 E

6 miles North of Booneville
(distance) (direction) (nearest town)

WELL PURPOSE: Home
(home, irrigation, municipal, industrial)

WELL COMPLETION DATA:

- (1) diameter (inches) 4
- (2) total depth (feet) 105
- (3) static water level (feet) 25 below top of ground.
- (4) casing Steel 63
(material) (depth)

CODED

(size) if telescope see back.

- (5) screen none
(length) (depth to top)

(size) (material)

- (6) pump 1/2 5
(HP) (yield gpm)

Electric
(type power)

- (7) electric log no
(yes or no)

(organization running log)

- (8) how well bottom plugged Open


DRILLERS REMARKS:

JUN 4 1971

MISS. BD. OF WATER COMM

If well telescopes please sketch and show depths.

GROUND LEVEL

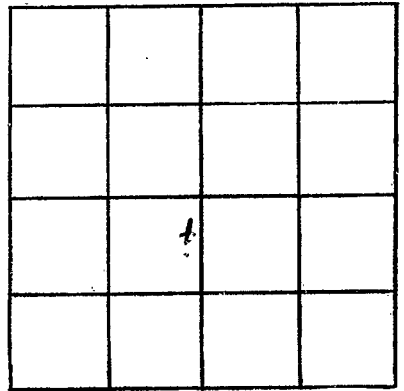

SECTION _____

Please indicate well location X.

ADDITIONAL INFORMATION

If more than one screen,
show locations of each on sketch.