

**MISSISSIPPI
BOARD OF WATER COMMISSIONERS**
416 North State Street
Jackson, Mississippi 39201

WATER WELL DRILLERS LOG

CODED

Prentiss
A 41
9-6-71

9-6 date well completed 1971 Bond Well Drilling firm name Prentiss county well located

LANDOWNER: <u>Randel Smith</u>	description of formations encountered	from	to
<u>Brownville Miss</u> (mailing address)	<u>Red clay</u> <u>Blue clay</u> <u>Water sand</u>	<u>0</u> <u>32</u> <u>211</u>	<u>32</u> <u>211</u> <u>258</u>
WELL LOCATION: sec. <u>14</u> T <u>4</u> N R <u>6</u> E <u>9</u> miles <u>West</u> of <u>Brownville</u> (distance) (direction) (nearest town)			
WELL PURPOSE: <u>Home</u> (home, irrigation, municipal, industrial)			
WELL COMPLETION DATA:			
(1) diameter (inches) <u>4</u>			
(2) total depth (feet) <u>258</u>			
(3) static water level (feet) <u>130</u> <u>below</u> above top of ground.			
(4) casing <u>Steel</u> , <u>41</u> (material) (depth)			
(size) if telescope see back.			
(5) screen <u>none</u> (length) (depth to top)			
(size) (material)			
(6) pump <u>3/4</u> <u>5</u> (HP) (yield gpm)			
<u>Electric pump</u> (type power)			
(7) electric log <u>no</u> (yes or no)			
(organization running log)			
(8) how well bottom plugged <u>open</u>			
DRILLERS REMARKS:			


CODED

UNIT 2 1074

MISS. ED. OF
WATER COMMISSIONERS

If well telescopes please sketch and show depths.

GROUND LEVEL

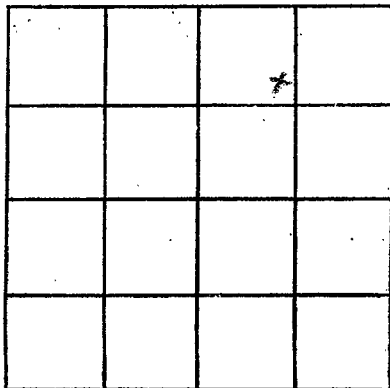

SECTION _____

Please indicate well location X.

ADDITIONAL INFORMATION

If more than one screen,
show locations of each on sketch.