

Prentiss
A42
11-11-71

MISSISSIPPI
BOARD OF WATER COMMISSIONERS
416 North State Street
Jackson, Mississippi 39201

DEC 9 1971

WATER WELL DRILLERS LOG **CODED**

11-11 date well completed 1971 Bond Well Drilling firm name Prentiss county well located

LANDOWNER: Neckey J. J. J. J.
Brownville Miss
(mailing address)
WELL LOCATION:
sec. 12 T 4 N R 6 E
 S W
7 miles N-W of Brownville
(distance) (direction) (nearest town)

description of formations encountered	from	to
<u>Red Clay</u>	<u>0</u>	<u>39</u>
<u>Blue Clay</u>	<u>39</u>	<u>185</u>
<u>Water sand</u>	<u>185</u>	<u>235</u>

WELL PURPOSE: Home
(home, irrigation, municipal, industrial)


- WELL COMPLETION DATA:
- (1) diameter (inches) 16
 - (2) total depth (feet) 235
 - (3) static water level (feet) 80 below above top of ground.
 - (4) casing Steel 16
(material) (depth)
(size) if telescope see back.
 - (5) screen none
(length) (depth to top)
(size) (material)
 - (6) pump 1/4 6
(HP) (yield gpm)
Electric Pump
(type power)
 - (7) electric log no
(yes or no)
(organization running log)
 - (8) how well bottom plugged Open

CODED

DRILLERS REMARKS:

If well telescopes please sketch and show depths.

GROUND LEVEL

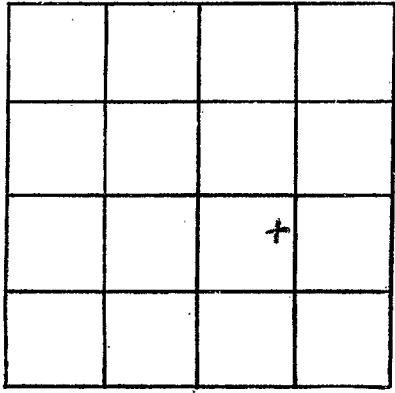

SECTION _____

Please indicate well location X.

ADDITIONAL INFORMATION

Lined area for additional information.

If more than one screen, show locations of each on sketch.