

PRENTISS MISSISSIPPI BOARD OF WATER COMMISSIONERS

A-44  
7-24-61

WATER WELL DRILLERS LOG

Date: 2/24, 1961, Driller: HERNDON WELL & SUPPLY CO. County Prentiss  
P.O. BOX #2  
SHANNON, MISSISSIPPI


(1) Owner of Land:	Description & Color of Materials Sand, Clay, Red Clay, Shell, etc.	Thick- ness Feet	Depth Feet
<u>Milton English</u> (Name) <u>Rt 3 Boonville, Miss.</u> (Address)	<u>surface sand</u> <u>&amp; clay</u>		<u>0</u>
(2) Location: <u>1/4</u> , <u>1/4</u> , Sec. <u>25</u> T. <u>45</u> R. <u>6E</u> <u>8</u> miles <u>North West</u> , of <u>Boonville</u> (distance) (direction) (Nearest Town)	<u>Blue rock</u> <u>&amp;</u> <u>Sand</u>		<u>155</u>  <u>300</u>
(3) Topography: <u>Hilly</u> (Hilly) (Flat) (Level)			
(4) Purpose of Well: <u>Domestic</u> (Domestic Irrigation Municipal, Industrial, Other)	<u>Bottom</u>		<u>420</u>

Information upon completion of well:

- (1) Diameter 4 inches.
- (2) Total Depth 420 feet.
- (3) Water Level 190 feet below top of ground.
- (4) Cased to 202', Size 4"
- (5) Screen: Size     , Length     .
- (6) Were any formations sealed against pollution?  
✓ yes,      no.

**CODED**

If YES depth of formation 195'  
Why surface & sand  
Drillers Remarks:     

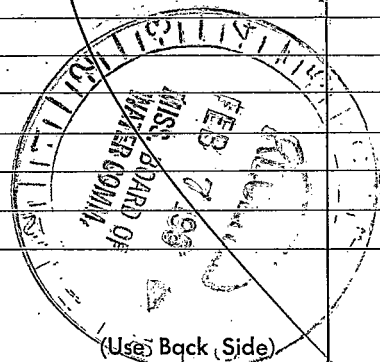

(Use) Bqck (Side)

Well No.

