

PRENTISS

A-45
10-62

WATER WELL DRILLERS LOG

HERNDON WELL & SUPPLY CO.


Date: Oct, 1962, Driller: P. O. BOX 42 County Prentiss
SHANNON Name MISSISSIPPI

| (1) Owner of Land | Description & Color of Materials Sand, Clay, Red Clay, Shell, etc. | Thick- ness Feet | Depth Feet |
|---|---|------------------------|---------------|
| <u>Community Well</u> (Name) | <u>sand & clay</u> | | 0 |
| <u>Jumpstown Miss</u> (Address) | | | 35 |
| (2) Location: <u>1/4</u> , <u>1/4</u> , Sec. <u>28</u> T. <u>43</u> R. <u>6E</u> | | | 150 |
| <u>1</u> miles <u>W</u> of <u>Jumpstown</u> (distance) (direction) (Nearest town) | | | 500 |
| (3) Topography: <u>Flat</u> (Hilly) (Flat) (Level) | | | |
| (4) Purpose of Well: <u>Domestic</u> (Domestic Irrigation Municipal, Industrial, Other) | | | |

Information upon completion of well:

- (1) Diameter 4 inches.
- (2) Total Depth 500 feet.
- (3) Water Level _____ feet below top of ground.
- (4) Cased to 204, Size 4" 2"
- (5) Screen: Size 2", Length 40'
- (6) Were any formations sealed against pollution?
yes, _____ no.

CODED

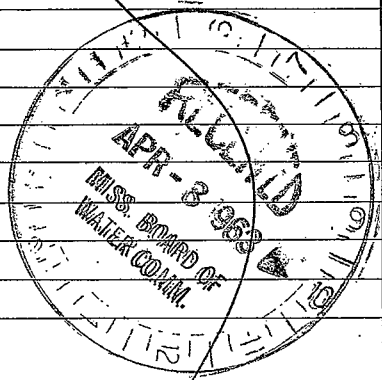

(Use Back Side)

Well No.

