

PRENTISS MISSISSIPPI BOARD OF WATER COMMISSIONERS

A-48
8-31-62

WATER WELL DRILLERS LOG

Date Aug 31, 1962, Driller: HERNDON WELL & SUPPLY CO. County Prentiss
P.O. BOX 42
 SHANNON, MISSISSIPPI

(1) Owner of Land:	Description & Color of Materials: Sand, Clay, Red Clay, Shell, etc.	Thick- ness Feet	Depth Feet
<u>Billy Brady</u> <small>(Name)</small> <u>Rt 3 Beareth, Miss</u> <small>(Address)</small>	<u>surface sand &</u> <u>clay</u>		<u>0</u>
(2) Location: <u>1/4</u> , <u>1/4</u> , Sec <u>28</u> T. <u>45</u> R. <u>6E</u> <u>1/2</u> miles <u>W</u> , <u>Imperial</u> <small>(distance) (direction) (Nearest Town)</small>	<u>Water with</u> <u>to</u>		<u>25</u>
(3) Topography: <u>1</u> <small>(Hilly) (Flat) (Level)</small>	<u>sand</u> <u>to</u>		<u>270</u>
(4) Purpose of Well: <u>Domestic</u> <small>(Domestic Irrigation Municipal, Industrial, Other)</small>	<u>Bottom</u>		<u>420</u>


Information upon completion of well:

- (1) Diameter 4 inches.
- (2) Total Depth 420 feet.
- (3) Water Level 150 feet below top of ground.
- (4) Cased to 30 ft, Size 4 in.
- (5) Screen: Size , Length .
- (6) Were any formations sealed against pollution?
 yes, no.

If YES depth of formation 25 ft.
Why surface & sand

Drillers Remarks:

CODED

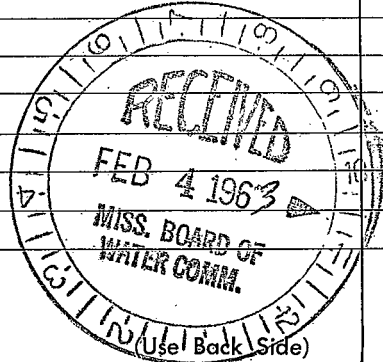

Well No. 55

