

PRENTISS MISSISSIPPI BOARD OF WATER COMMISSIONERS

A-50
4-23-63

WATER WELL DRILLERS LOG

Date: 4/23, 1963, Driller: SHANNON WELL & SUPPLY CO. County: Prentiss
P. O. BOX 42
 SHANNON, MISSISSIPPI

(1) Owner of Land:	Description & Color of Materials Sand, Clay, Red Clay, Shell, etc.	Thick- ness Feet	Depth Feet
<u>J. R. Eaton</u> <small>(Name)</small> <u>At 3 Crossville, Miss</u> <small>(Address)</small>	<u>surface sand & clay</u>		<u>0</u>
(2) Location: <u>1/4, 1/4, Sec 27 T 45 R 6E</u> <u>1</u> miles <u>E</u> , of <u>Jumpertown</u> <small>(distance) (direction) (Nearest Town)</small>	<u>Blue rock</u> <u>sand</u>		<u>40</u> <u>240</u>
(3) Topography: <u>Hilly</u> <small>(Hilly) (Flat) (Level)</small>	<u>Bottom</u>		<u>360</u>
(4) Purpose of Well: <u>Domestic</u> <small>(Domestic Irrigation Municipal, Industrial, Other)</small>			


Information upon completion of well:

- (1) Diameter 4 inches.
- (2) Total Depth 360 feet.
- (3) Water Level 157' feet below top of ground.
- (4) Cased to 42', Size 4"
- (5) Screen: Size —, Length 2
- (6) Were any formations sealed against pollution?
✓ yes, — no.

If YES depth of formation 40'
Why surface & sand

Drillers Remarks:

CODED

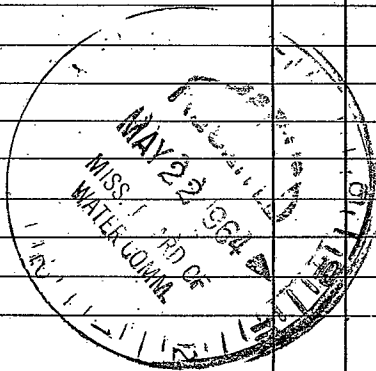

(Use Back Side)

Well No.

1917
1918
1919