

PRENTISS MISSISSIPPI BOARD OF WATER COMMISSIONERS

A-51  
7-12-63

WATER WELL DRILLERS LOG

HERRIDON WELL & SUPPLY CO.

Date: 7/12, 1963, Driller: SHANNON County Prentiss

P. O. BOX 42  
SHANNON, MISSISSIPPI


(1) Owner of Land:	Description & Color of Materials Sand, Clay, Red Clay, Shell, etc.	Thick- ness Feet	Depth Feet
(Name) <u>Howard Corbin</u> <u>At 3 Ozark, Miss</u> (Address)	<u>surface sand</u> <u>&amp; clay</u>		<u>0</u>
(2) Location: <u>1/4, 1/4, Sec 22 T. 45 R. 6E</u> <u>1/2</u> miles <u>N</u> of <u>Sumner</u> (distance) (direction) (Nearest Town)	<u>Blue rock</u> <u>sand</u>		<u>32</u> <u>260</u>
(3) Topography: <u>Hilly</u> (Hilly) (Flat) (Level)	<u>to</u>		
(4) Purpose of Well: <u>Domestic</u> (Domestic Irrigation Municipal, Industrial, Other)	<u>Bottom</u>		<u>380</u>

Information upon completion of well:

- (1) Diameter 4 inches.
- (2) Total Depth 380 feet.
- (3) Water Level 140 feet below top of ground.
- (4) Cased to 351, Size 44.
- (5) Screen: Size \_\_\_\_\_, Length \_\_\_\_\_.
- (6) Were any formations sealed against pollution?  
\_\_\_\_\_ yes, \_\_\_\_\_ no.

If YES depth of formation 32'  
Why surface sand  
Drillers Remarks:

**CODED**

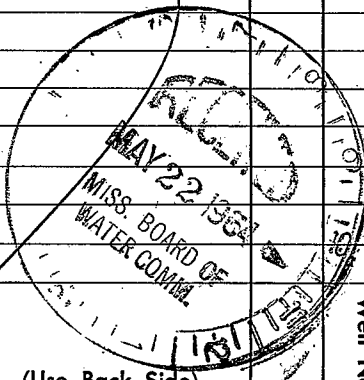

Well No.

(Use Back Side)

