

Prentiss
A-53
6-67

MISSISSIPPI
BOARD OF WATER COMMISSIONERS
416 North State Street
Jackson, Mississippi 39201

WATER WELL DRILLERS LOG

June 2 1967 Bond Plumbing Prentiss
date well completed firm name county well located

LANDOWNER: Donald Bridges

description of formations encountered	from	to
Sandy Clay	0'	19'
Blue " "	19'	320'
Water Sand	320'	384'

R3
Rienzi Miss
(mailing address)

WELL LOCATION:
sec. 14 T. 4 N R. 1 E
8 miles WNW of Boone
(distance) (direction) (nearest town)


WELL PURPOSE: Home
(home, irrigation, municipal, industrial)

WELL COMPLETION DATA:

- (1) diameter (inches) 4
- (2) total depth (feet) 384
- (3) static water level (feet) 195 below top of ground.
- (4) casing (material) BK Steel (depth) 21 1/2
- 4" if telescope see back. (size)
- (5) screen none (length) (depth to top)
- (size) (material)
- (6) pump 2 (HP) 4 (yield gpm)
Elet Jet (type power)
- (7) electric log no (yes or no)
none (organization running log)
- (8) how well bottom plugged Open


CODED

DRILLERS REMARKS:

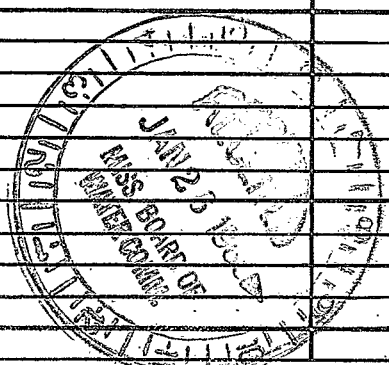

If well telescopes please sketch and show depths.

GROUND LEVEL

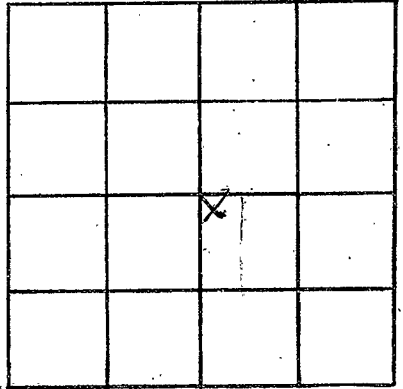

SECTION 15

Please indicate well location X.

ADDITIONAL INFORMATION

If more than one screen,
show locations of each on sketch.