

**MISSISSIPPI  
BOARD OF WATER COMMISSIONERS**  
416 North State Street  
Jackson, Mississippi 39201

**WATER WELL DRILLERS LOG**

PRENTISS  
A-54  
3-68

Mar 2 date well completed      68 Bonds Plumbing & Drilling Co firm name      Prentiss county well located

LANDOWNER: Charles Hill  
Route 3  
Kenji Miss (mailing address)


description of formations encountered	from	to
<u>Red Sandy Clay</u>	<u>0</u>	<u>20</u>
<u>Blue Clay</u>	<u>25</u>	<u>310</u>
<u>Water Sand</u>	<u>310</u>	<u>360</u>

WELL LOCATION:  
sec. 16 T 4 N R 6 E  
7 miles W of Boonville  
(distance) (direction) (nearest town)

WELL PURPOSE: Home  
(home, irrigation, municipal, industrial)

- WELL COMPLETION DATA:
- (1) diameter (inches) 4"
  - (2) total depth (feet) 370
  - (3) static water level (feet) 180 below top of ground.
  - (4) casing Steel 31  
(material) (depth)  
4" if telescope see back.  
(size)
  - (5) screen none  
(length) (depth to top)  
none  
(size) (material)
  - (6) pump 5 5  
(HP) (yield gpm)  
elect.  
(type power)
  - (7) electric log none  
(yes or no)  
(organization running log)
  - (8) how well bottom plugged Open


**CODED**

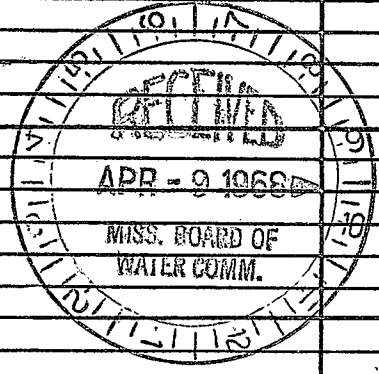

DRILLERS REMARKS:

If well telescopes please sketch and show depths.

GROUND LEVEL

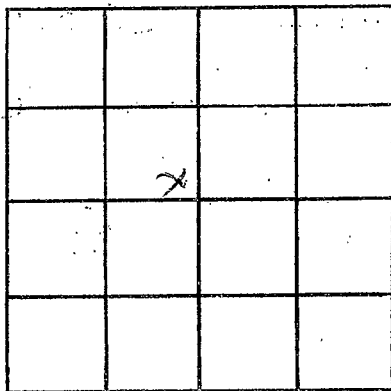

SECTION 16

Please indicate well location X.

ADDITIONAL INFORMATION

Lined area for additional information.

If more than one screen, show locations of each on sketch.