

PRENTISS
A-55
5-68

MISSISSIPPI
BOARD OF WATER COMMISSIONERS
416 North State Street
Jackson, Mississippi 39201

WATER WELL DRILLERS LOG

May 3 1968 68 Bonds Plk + Drilling Prentiss
date well completed firm name county well located

LANDOWNER E. J. Johnson

description of formations encountered

from to

net - known

Sandy Clay
Sand
Blue clay
Water Sand

0 24
24 41
41 335
335 1100

(mailing address)

WELL LOCATION:

sec 7 T 4 N R 6 E
S W
10 1/2 miles NW of Barnwell
(distance) (direction) (nearest town)

WELL PURPOSE: Home
(home, irrigation, municipal, industrial)

WELL COMPLETION DATA:

- (1) diameter (inches) 4
- (2) total depth (feet) 400
- (3) static water level (feet) 151 below above top of ground.
- (4) casing Steel, 42,
" (material), (depth)
None if telescope see back.
(size)
- (5) screen _____ (length) _____ (depth to top)
(size) _____ (material)
- (6) pump 2 hp 5
(HP) (yield gpm)
Elect
(type power)
- (7) electric log none
(yes or no)
(organization running log)
- (8) how well bottom plugged Open

CODED


MAY 28 1968

MISS. DIV. OF WATER CONTROL

DRILLERS REMARKS:

If well telescopes please sketch and show depths.

GROUND LEVEL

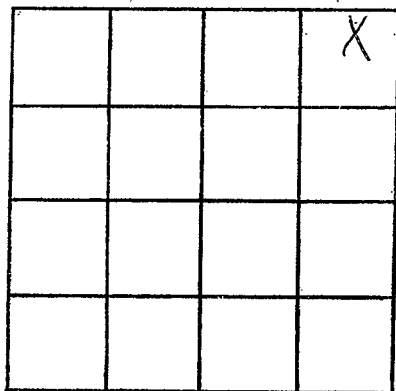

SECTION 7

Please indicate well location X.

ADDITIONAL INFORMATION

If more than one screen,
show locations of each on sketch.