

Prentiss  
A-56  
5-31-68

MISSISSIPPI  
BOARD OF WATER COMMISSIONERS  
416 North State Street  
Jackson, Mississippi 39201

WATER WELL DRILLERS LOG

May 31 1968 Bands Prentiss  
date well completed firm name county well located

LANDOWNER: Leland Davis  
Rt 3 Leuzie Miss  
(mailing address)


WELL LOCATION:  
sec. 9 T. 4 N R. 6 E  
3 miles WNW of Leuzie  
(distance) (direction) (nearest town)

WELL PURPOSE: Home  
(home, irrigation, municipal, industrial)

- WELL COMPLETION DATA:
- (1) diameter (inches) 4
  - (2) total depth (feet) 380
  - (3) static water level (feet) 166 below above top of ground.
  - (4) casing Steel, 63  
(material) (depth)  
4" pipe  
(size) if telescope see back.
  - (5) screen none  
(length) (depth to top)  
none  
(size) (material)
  - (6) pump 2 0.5  
(HP) (yield gpm)  
Elect  
(type power)
  - (7) electric log no  
(yes or no)  
none  
(organization running log)
  - (8) how well bottom plugged open

description of fomations encountered	from	to
Red Clay	8	10
Gray " "	10	19
Hardy Blue clay	19	51
Sand	51	60
Blue clay	60	255
" " + shells	255	315
Water Sand	315	380


**CODED**

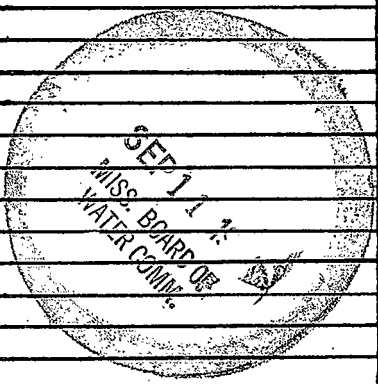

DRILLERS REMARKS:

If well telescopes please sketch and show depths.

GROUND LEVEL

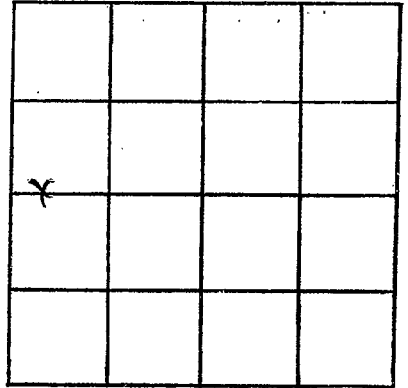

SECTION 9

Please indicate well location X.

ADDITIONAL INFORMATION

If more than one screen,  
show locations of each on sketch.