

**MISSISSIPPI
BOARD OF WATER COMMISSIONERS**
416 North State Street
Jackson, Mississippi 39201

WATER WELL DRILLERS LOG

Prentiss
A-57
6-25-68

June 25 1968 Bonds Prentiss
date well completed firm name county well located

LANDOWNER: Charles Beck
Booneville, Miss

description of formations encountered	from	to
<u>Red clay</u>	<u>0</u>	<u>12</u>
<u>Sand</u>	<u>12</u>	<u>39</u>
<u>Blue Clay (Sandy)</u>	<u>39</u>	<u>95</u>
<u>Rock</u>	<u>95</u>	<u>125</u>
<u>Sandy Blue Clay</u>	<u>97</u>	<u>125</u>
<u>White Sand</u>	<u>125</u>	<u>192</u>

(mailing address)

WELL LOCATION:


sec. 24 T 4 N R 6 E
S W
75 miles NE of Booneville
(distance) (direction) (nearest town)

WELL PURPOSE: Home
(home, irrigation, municipal, industrial)

WELL COMPLETION DATA:

- (1) diameter (inches) 4
- (2) total depth (feet) 192 ft
- (3) static water level (feet) 70 below top of ground.
- (4) casing Steel, 42,
(material) (depth)
4" if telescope see back.
(size)
- (5) screen none
(length) (depth to top)
none
(size) (material)
- (6) pump Installed own pump
(type) (yield gpm)
- (7) electric log no
(yes or no)
none
(organization running log)
- (8) how well bottom plugged Open


VOID

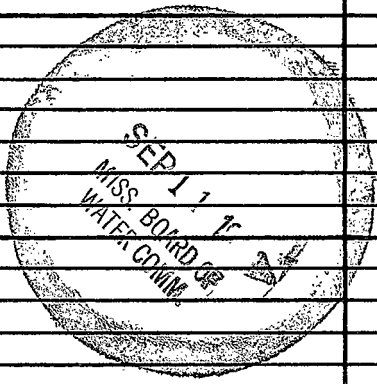

DRILLERS REMARKS:

If well telescopes please sketch and show depths.

GROUND LEVEL

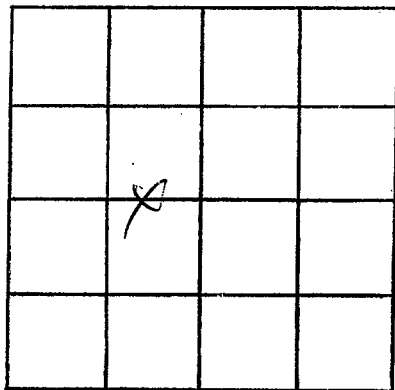

SECTION 26

Please indicate well location X.

ADDITIONAL INFORMATION

If more than one screen,
show locations of each on sketch.